

MARION

J 11

4-67

MISSISSIPPI
 BOARD OF WATER COMMISSIONERS ^{CODED}
 416 North State Street
 Jackson, Mississippi 39201

WATER WELL DRILLERS LOG

H-12 1967 Reagan & Soil Marion
 date well completed firm name county well located

LANDOWNER: Homer Reagan

description of formations encountered

from

to

ht 1 Kobow, Miss

clay
coarse sand

0 60
60 84

(mailing address)

WELL LOCATION:

sec 20 T 3 N R 12 E
 S W
2 miles NW of Kobow
 (distance) (direction) (nearest town)

CODED

WELL PURPOSE: home
 (home, irrigation, municipal, industrial)

WELL COMPLETION DATA:

- (1) diameter (inches) 2"
- (2) total depth (feet) 84'
- (3) static water level (feet) 20' ^{below} top ^{above} of ground.
- (4) casing Gal. 83'
 (material) (depth)
 _____ If telescope see back.
 (size)
- (5) screen 3' 83'
 (length) (depth to top)
.010 Stainless Steel
 (size) (material)
- (6) pump 1/2 _____
 (HP) (yield gpm)
Elect
 (type power)
- (7) electric log no
 (yes or no)


 (organization running log)
- (8) how well bottom plugged Back
with water

DRILLERS REMARKS:

MISSISSIPPI
 BOARD OF
 WATER COMMISSIONERS

If well telescopes please sketch and show depths.

GROUND LEVEL

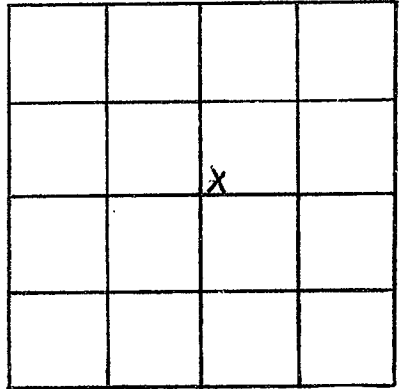

SECTION 20

Please indicate well location X.

ADDITIONAL INFORMATION

If more than one screen, show locations of each on sketch.