

MARION  
J 13  
4-67

MISSISSIPPI  
BOARD OF WATER COMMISSIONERS CODED  
416 North State Street  
Jackson, Mississippi 39201

WATER WELL DRILLERS LOG

4-7 1967 Regent Soil Marion  
date well completed firm name county well located

LANDOWNER: Allen Lyles

RT. 1 Kokomo, Miss

(mailing address)

WELL LOCATION:

sec 26 T 3 (N) R 12 (E)  
S W  
3 miles E of Kokomo  
(distance) (direction) (nearest town)

WELL PURPOSE: house  
(home, irrigation, municipal, industrial)

WELL COMPLETION DATA:

- (1) diameter (inches) 2"
- (2) total depth (feet) 170'
- (3) static water level (feet) 45' <sup>below</sup> <sub>above</sub> top of ground.
- (4) casing plast. 167'  
(material) (depth)  
if telescope see back.  
(size)
- (5) screen 3' 167'  
(length) (depth to top)  
1010 Stainless Steel  
(size) (material)
- (6) pump 1   
(HP) (yield gpm)  
elect.  
(type power)
- (7) electric log no  
(yes or no)  
(organization running log)
- (8) how well bottom plugged Back  
wash valve

description of formations encountered	from	to
<u>Clay</u>	<u>0</u>	<u>100</u>
<u>Red Sand</u>	<u>100</u>	<u>130</u>
<u>Pea Gravel</u>	<u>130</u>	<u>170</u>

CODED


RECORDED - 5 1968  
MISS. BOARD OF  
WATER COMMISSIONERS

DRILLERS REMARKS:

If well telescopes please sketch and show depths.

GROUND LEVEL

N

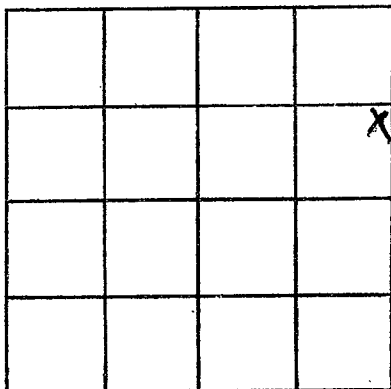

SECTION 26

Please indicate well location X.

ADDITIONAL INFORMATION

If more than one screen,  
show locations of each on sketch.