

MARION  
 J 14  
 4-67

MISSISSIPPI  
 BOARD OF WATER COMMISSIONERS  
 416 North State Street  
 Jackson, Mississippi 39201

CODED

WATER WELL DRILLERS LOG

4-14-1967 date well completed  
 Reagan & Foil firm name  
 Marion county well located

LANDOWNER: Robert Pittman  
 Rt. 1 Robson, Missi

description of formations encountered	from	to
Clay	0	102
Red sand	102	118
Red gravel	118	171

(mailing address)

WELL LOCATION:  
 sec. 36 T 2 N R 20 E S 5  
 2 1/2 miles SE of Robson  
 (distance) (direction) (nearest town)

CODED

WELL PURPOSE: none  
 (home, irrigation, municipal, industrial)

WELL COMPLETION DATA:


- (1) diameter (inches) 2"
- (2) total depth (feet) 171'
- (3) static water level (feet) 41' below top of ground.
- (4) casing Gal. 168' (material) (depth)
- (size) If telescope see back.
- (5) screen 3' 168' (length) (depth to top)
- 010 Stainless Steel (size) (material)
- (6) pump 2 (HP) (yield gpm)
- Elect (type power)
- (7) electric log No (yes or no)
- (organization running log)
- (8) how well bottom plugged Back wash valve

DRILLERS REMARKS:

MISSISSIPPI BOARD OF WATER COMMISSIONERS

If well telescopes please sketch and show depths.

GROUND LEVEL

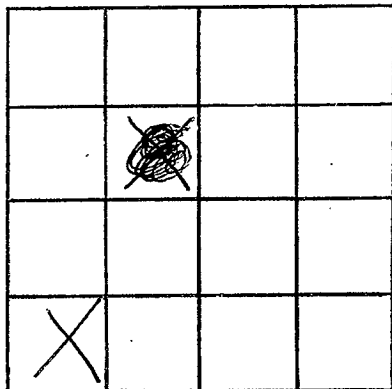

SECTION 36

Please indicate well location X.

ADDITIONAL INFORMATION

If more than one screen, show locations of each on sketch.