

Marion  
 T 16  
 5-67

MISSISSIPPI  
 BOARD OF WATER COMMISSIONERS CODED  
 416 North State Street  
 Jackson, Mississippi 39201

WATER WELL DRILLERS LOG

5/10 1967 Andy's Drilling Marion  
 date well completed firm name county well located

LANDOWNER:

Theodore Beumfield  
Pt. 1 Kokomo, Miss.  
 (mailing address)

description of formations encountered

from to

Red clay	0'	20'
Red Sand	20'	60'
GRAVEL	60'	80'
Sand	80'	100'
Coarse sand / gravel	100'	110'

WELL LOCATION:

sec 7 T 3 N R 12 E  
4 1/2 miles N.W. of Kokomo  
 (distance) (direction) (nearest town)

WELL PURPOSE:

Home  
 (home, irrigation, municipal, industrial)

WELL COMPLETION DATA:

- (1) diameter (inches) 4"
- (2) total depth (feet) 110'
- (3) static water level (feet) 80' below above top of ground.
- (4) casing P.V.C., 104'  
 (material) (depth)  
4" if telescope see back.  
 (size)
- (5) screen 6', 104'  
 (length) (depth to top)  
4", P.V.C.  
 (size) (material)
- (6) pump 3/4, 12  
 (HP) (yield gpm)


REA. 220  
 (type power)

(7) electric log no  
 (yes or no)

(organization running log)


(8) how well bottom plugged Back  
Wash down

DRILLERS REMARKS:

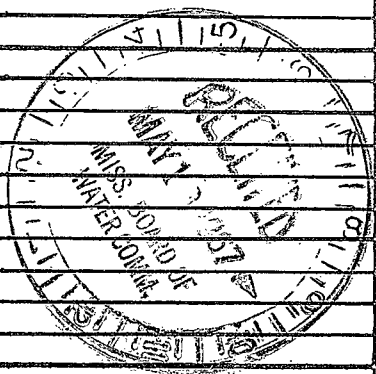

If well telescopes please sketch and show depths.

GROUND LEVEL

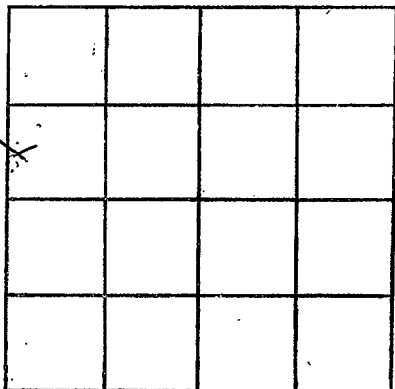

SECTION 7

Please indicate well location X.

ADDITIONAL INFORMATION

If more than one screen,  
show locations of each on sketch.