

MARION
 J 11
 6-67

MISSISSIPPI
 BOARD OF WATER COMMISSIONERS
 416 North State Street
 Jackson, Mississippi 39201

CODED

WATER WELL DRILLERS LOG

6-72-1967 Regent Fall Marion
 date well completed firm name county well located

LANDOWNER: James Allen Regent Rt. Kobons	Description of formations encountered Clay Coarse sand	from	to
		0	155

(mailing address)

WELL LOCATION:
 sec. 27 T. 30 N. R. 12 E
 S W
 1 miles E of Kobono
 (distance) (direction) (nearest town)

CODED

WELL PURPOSE: home
 (home, irrigation, municipal, industrial)


- WELL COMPLETION DATA:
- (1) diameter (inches) 4"
 - (2) total depth (feet) 200'
 - (3) static water level (feet) 45 below top of ground.
 - (4) casing plast., 190'
 (material) (depth)
 (size) if telescope see back.
 - (5) screen 10', 190'
 (length) (depth to top)
010, plast.
 (size) (material)
 - (6) pump 3/4 (HP) (yield gpm)
elect.
 (type power)
 - (7) electric log no
 (yes or no)
 (organization running log)
 - (8) how well bottom plugged Back
wash valve

JUN 5 1968
 MISS. BOARD OF
 WATER COMM.

DRILLERS REMARKS:

If well telescopes please sketch and show depths.

GROUND LEVEL

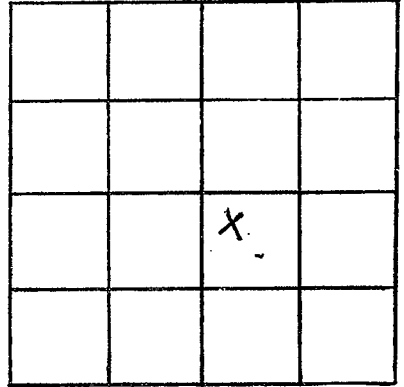

SECTION 27

Please indicate well location X.

ADDITIONAL INFORMATION

If more than one screen, show locations of each on sketch.