

Marion
 518
 6-67

MISSISSIPPI
 BOARD OF WATER COMMISSIONERS
 416 North State Street
 Jackson, Mississippi 39201

WATER WELL DRILLERS LOG

6-29 date well completed
 67 Fitzgerald Water Well firm name
 Marion county well located

LANDOWNER: Smiley Smith

RT1 Box 307A

Kokomo, Miss
 (mailing address)

WELL LOCATION:

sec 21 T 3 N R 12 E
 S W
1 miles N of Kokomo
 (distance) (direction) (nearest town)

WELL PURPOSE: home
 (home, irrigation, municipal, industrial)

WELL COMPLETION DATA:

- (1) diameter (inches) 4
- (2) total depth (feet) 126
- (3) static water level (feet) 100 below/above top of ground.
- (4) casing plastic, 120
 (material) (depth)
4 if telescope see back.
 (size)
- (5) screen 8, 120
 (length) (depth to top)
4, plastic
 (size) (material)
- (6) pump _____
 (HP) (yield gpm)

 (type power) Bucket
- (7) electric log No
 (yes or no)


 (organization running log)
- (8) how well bottom plugged Wood peg

description of formations encountered

from to

top soil & clay	0	15
Red sand & Red Chalk	15	55
Yellow coarse sand	55	118
pe gravel & sand	118	120


COVERED

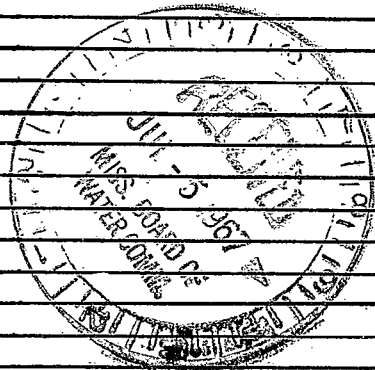

DRILLERS REMARKS:

If well telescopes please sketch and show depths.

GROUND LEVEL

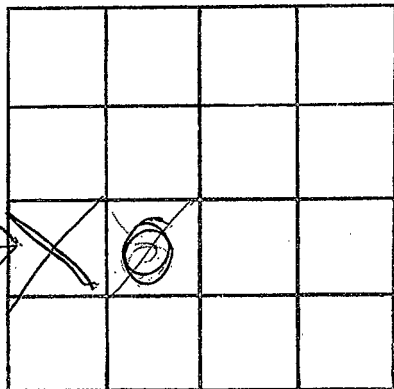

SECTION 21

Please indicate well location X.

ADDITIONAL INFORMATION

If more than one screen,
show locations of each on sketch.