

MARION  
 J 19  
 9-67

MISSISSIPPI  
 BOARD OF WATER COMMISSIONERS  
 416 North State Street  
 Jackson, Mississippi 39201

CODED

WATER WELL DRILLERS LOG

9-7 1967 Reogant Fair Marion  
 date well completed firm name county well located

LANDOWNER: <i>Virgil Bedwell</i>	(description of formations encountered)	from	to
<i>Rt. 2 Fardworth, Miss</i>	<i>Clay</i>	<i>0</i>	<i>177</i>
	<i>Crass sand</i>	<i>177</i>	<i>189</i>

(mailing address)

WELL LOCATION:  
 sec. 36 T. 30 N. R. 20 E.  
 S. W.  
4 miles SE of Kokomo  
 (distance) (direction) (nearest town)

WELL PURPOSE:  
 (home, irrigation, municipal, industrial)


WELL COMPLETION DATA:

- (1) diameter (inches) 4"
- (2) total depth (feet) 189'
- (3) static water level (feet) 13' below top of ground.
- (4) casing plast, 178'  
 (material) (depth)
- if telescope see back.  
 (size)
- (5) screen 10', 179'  
 (length) (depth to top)
- 0.10, plast  
 (size) (material)
- (6) pump 1 1/2           
 (HP) (yield gpm)
- Elect  
 (type power)
- (7) electric log no  
 (yes or no)

CODED

- (organization running log)
- (8) how well bottom plugged Back  
wash valve


DRILLERS REMARKS:

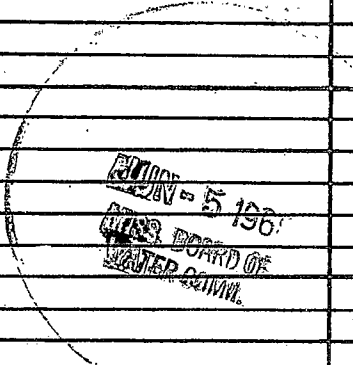

If well telescopes please sketch and show depths.

GROUND LEVEL

N

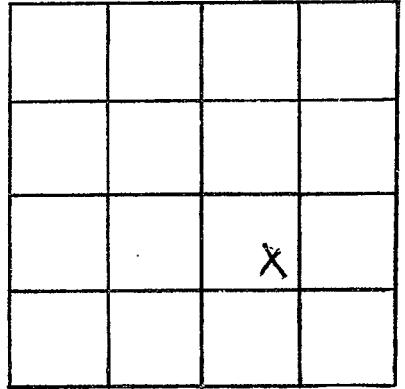

SECTION 36

Please indicate well location X.

ADDITIONAL INFORMATION

If more than one screen, show locations of each on sketch.