

MISSISSIPPI
 BOARD OF WATER COMMISSIONERS CODED
 416 North State Street
 Jackson, Mississippi 39201

WATER WELL DRILLERS LOG

MARION
 J 20
 10-67

10-6 1967 Reagan & Fails Marion
 date well completed firm name county well located

LANDOWNER: Eugene Summers	description of formations encountered	depth	
		from	to
Pt 1 Kohovo (mailing address)	Clay	0	150
	Red sand	150	181
	Coarse sand	181	211

WELL LOCATION:
 sec. 26 T 3 N R 12 E
 S W
 1 miles E of Kohovo
 (distance) (direction) (nearest town)

CODED

WELL PURPOSE:
 (home, irrigation, municipal, industrial)

WELL COMPLETION DATA:

(1) diameter (inches) 2"

(2) total depth (feet) 211'

(3) static water level (feet) 30 below above top of ground.

(4) casing gal 208'
 (material) (depth)

_____ if telescope see back.
 (size)

(5) screen 3' 208'
 (length) (depth to top)
.010 Stainless Steel
 (size) (material)

(6) pump 2 _____
 (HP) (yield gpm)
elect
 (type power)

(7) electric log NO
 (yes or no)

_____ (organization running log)

(8) how well bottom plugged Back
wash valve


DRILLERS REMARKS:

EX-105-1360
 MISS. BOARD OF
 WATER COMMISSIONERS

If well telescopes please sketch and show depths.

GROUND LEVEL

N

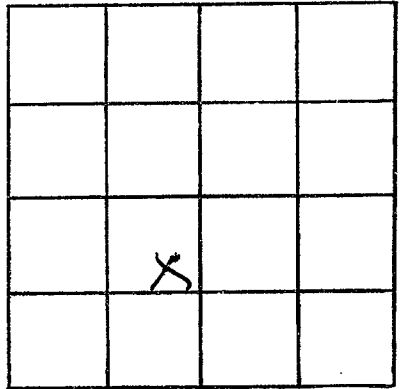

SECTION 26

Please indicate well location X.

ADDITIONAL INFORMATION

If more than one screen, show locations of each on sketch.