

MARION  
J. 21  
2-68

MISSISSIPPI  
BOARD OF WATER COMMISSIONERS CODED  
416 North State Street  
Jackson, Mississippi 39201

WATER WELL DRILLERS LOG

2-17 1968 Reagan & Fails Marion  
date well completed firm name county well located

LANDOWNER: Dudley Fails

Rt. 1 Kobomo, Miss.

(mailing address)

description of formations encountered

from to

Clay	0	50
Red sand	50	75
white sand	75	100

WELL LOCATION:

sec. 29 T. 3 N. R. 12 E.  
S W  
1/2 miles W of Kobomo  
(distance) (direction) (nearest town)

WELL PURPOSE: home  
(home, irrigation, municipal, industrial)

CODED

WELL COMPLETION DATA:

(1) diameter (inches) 4"  
(2) total depth (feet) 100'  
(3) static water level (feet) 25' below top of ground.

(4) casing plast. 90'  
(material) (depth)

\_\_\_\_\_ if telescope see back.  
(size)

(5) screen 10' 90'  
(length) (depth to top)

.010 Plastic  
(size) (material)

(6) pump 3/4 \_\_\_\_\_  
(HP) (yield gpm)


Elec.  
(type power)

(7) electric log no  
(yes or no)

\_\_\_\_\_ (organization running log)


(8) how well bottom plugged Back  
Wash Valve

DRILLERS REMARKS:

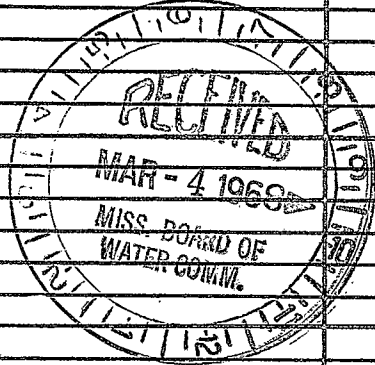

If well telescopes please sketch and show depths.

GROUND LEVEL

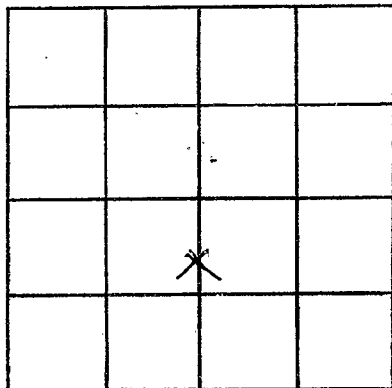

SECTION \_\_\_\_\_

Please indicate well location X.

ADDITIONAL INFORMATION

If more than one screen, show locations of each on sketch.