

MARION
J 22
2-68

MISSISSIPPI
BOARD OF WATER COMMISSIONERS
416 North State Street **CODED**
Jackson, Mississippi 39201

WATER WELL DRILLERS LOG

2-20 1968 *Regent Soil* Marion
date well completed firm name county well located

LANDOWNER: *Ronald Cley*
Rt. 1 Hobson, Miss.

description of formations encountered	from	to
<i>Red clay</i>	<i>0</i>	<i>90</i>
<i>Red sand</i>	<i>90</i>	<i>110</i>
<i>Pea gravel</i>	<i>110</i>	<i>180</i>


(mailing address)

WELL LOCATION:
sec. *28* T *3* N R *12* W
S W
1/4 miles *E* of *Hobson*
(distance) (direction) (nearest town)

WELL PURPOSE: *Home*
(home, irrigation, municipal, industrial)

- WELL COMPLETION DATA:
- (1) diameter (inches) *4"*
 - (2) total depth (feet) *180'*
 - (3) static water level (feet) *70* ^(below) _(above) top of ground.
 - (4) casing *plastic*, *170'*
(material) (depth)
 - _____ if telescope see back.
(size)
 - (5) screen *10'*, *170'*
(length) (depth to top)
 - .010*, *plastic*
(size) (material)
 - (6) pump *3/4*
(HP) (yield gpm)
 - elect.*
(type power)
 - (7) electric log *no*
(yes or no)
 - _____ (organization running log)
 - (8) how well bottom plugged *Back*
Wash Water


CODED

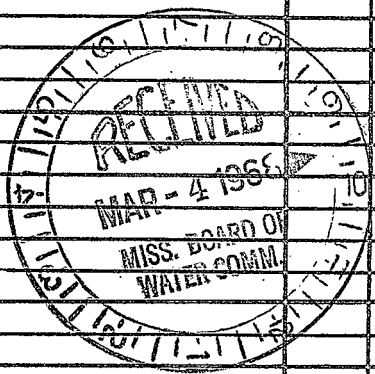

DRILLERS REMARKS:

If well telescopes please sketch and show depths.

GROUND LEVEL

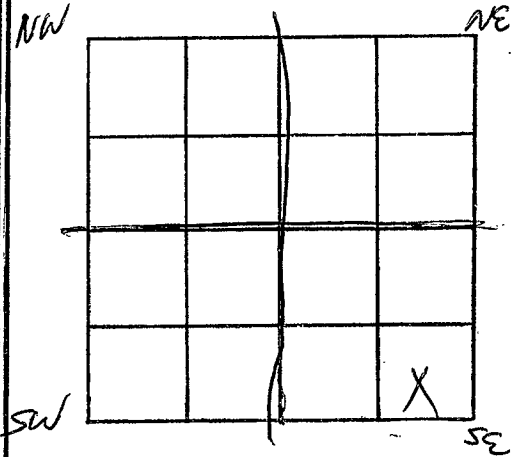

SECTION _____

Please indicate well location X.

ADDITIONAL INFORMATION

If more than one screen, show locations of each on sketch.