

Marion
 8 24
 4-68
~~4-68~~

MISSISSIPPI
 BOARD OF WATER COMMISSIONERS
 416 North State Street
 Jackson, Mississippi 39201

CODED

WATER WELL DRILLERS LOG

4-27 1968 Reason & Fair Marion
 date well completed firm name county well located

LANDOWNER: Fred Jones

Rt Forworth

(mailing address)

description of formations encountered

from	to
0	90
90	100
100	132

Clay
Sand
pea gravel

WELL LOCATION:

sec. 35 T. 3 N. R. 12 E.
 S W
3 miles S of Kebons
 (distance) (direction) (nearest town)

CODED

WELL PURPOSE: home
 (home, irrigation, municipal, industrial)


WELL COMPLETION DATA:

- diameter (inches) 4"
- total depth (feet) 132'
- static water level (feet) 37' below above top of ground.
- casing Plasti., 124'
 (material) (depth)
 _____ if telescope see back.
 (size)
- screen 8', 124'
 (length) (depth to top)
.008, Plasti
 (size) (material)
- pump 1/2 _____
 (HP) (yield gpm)
Elco
 (type power)
- electric log NO
 (yes or no)

(organization running log)


(8) how well bottom plugged Back
wash rod

DRILLERS REMARKS:

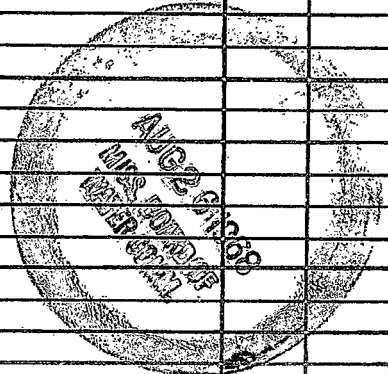

If well telescopes please sketch and show depths.

GROUND LEVEL

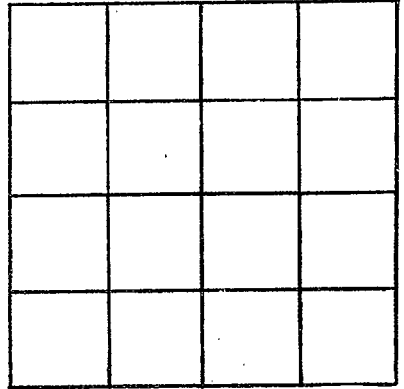

SECTION _____

Please indicate well location X.

ADDITIONAL INFORMATION

If more than one screen, show locations of each on sketch.