

Marion
 J 26
 4-23-69

MISSISSIPPI
 BOARD OF WATER COMMISSIONERS
 416 North State Street
 Jackson, Mississippi 39201

CODED

WATER WELL DRILLERS LOG

4/23 1969 Dean Strimer Marion Co.
 date well completed firm name county well located

LANDOWNER:
 Bennie A. Jarrell
 Route 7, Joltown, Miss.
 (mailing address)

description of formations encountered	from	to
Top soil	0	1
red clay	1	10
yellow sand	10	30
fine sand	30	80
Coarse water sand	80	110

WELL LOCATION:
 sec 32 T 5 N R 12 E S W
 7 miles N.E. of Joltown
 (distance) (direction) (nearest town)

WELL PURPOSE: Home Use
 (home, irrigation, municipal, industrial)

WELL COMPLETION DATA:

(1) diameter (inches) 4" well

(2) total depth (feet) 110' deep

(3) static water level (feet) 35' below top of ground.

(4) casing Plastic, 100'
 (material) (depth)

_____ if telescope see back.
 (size)

(5) screen 10' 100'
 (length) (depth to top)

4" Plastic
 (size) (material)

(6) pump 1/2 (HP) _____ (yield gpm)

_____ (type power)

(7) electric log No (yes or no)

_____ (organization running log)

(8) how well bottom plugged _____

CODED


MAR 18 1970

MISS. BD. OF
 WATER COMM.

DRILLERS REMARKS:

If well telescopes please sketch and show depths.

GROUND LEVEL

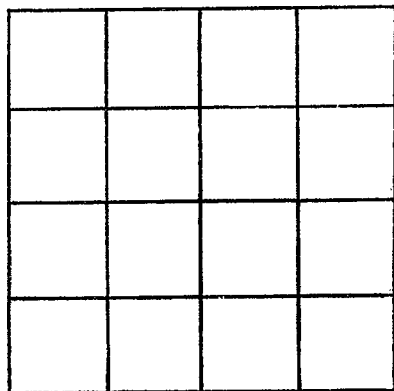

SECTION _____

Please indicate well location X.

ADDITIONAL INFORMATION

If more than one screen,
show locations of each on sketch.