

Marion
 J 21
 5-12-69

MISSISSIPPI
 BOARD OF WATER COMMISSIONERS
 416 North State Street
 Jackson, Mississippi 39201

INDEXED

WATER WELL DRILLERS LOG

5/12 1969 Dean Grimes Marion
 date well completed firm name county well located

LANDOWNER:

Eusach Watson
 Route 2 Forworth, Miss.
 (mailing address)

description of formations encountered

from to

Top soil	0-1
red clay	1-20
Red sand	20-45
Gravel	45-75
Chalk	75-145
Gravel	145-190
fine sand	190-225
Water sand	225-250

WELL LOCATION:

sec 25 T 2 N R 12 E
 S W
 7 miles S.W. of Forworth
 (distance) (direction) (nearest town)

WELL PURPOSE: Home Use
 (home, irrigation, municipal, industrial)

WELL COMPLETION DATA:

- (1) diameter (inches) 4"
- (2) total depth (feet) 250'
- (3) static water level (feet) _____ below above top of ground.
- (4) casing Plastic 240' (material) (depth)
 (size) if telescope see back.
- (5) screen 10' 240' (length) (depth to top)
 4" Plastic (size) (material)
- (6) pump 1/2 HP Jacuzzi sub pump (HP) (yield gpm) (type power)
- (7) electric log No (yes or no)
 (organization running log)
- (8) how well bottom plugged _____

INDEXED


MAR 18 1970

MISS. BD. OF WATER COMM.

DRILLERS REMARKS:

If well telescopes please sketch and show depths.

GROUND LEVEL

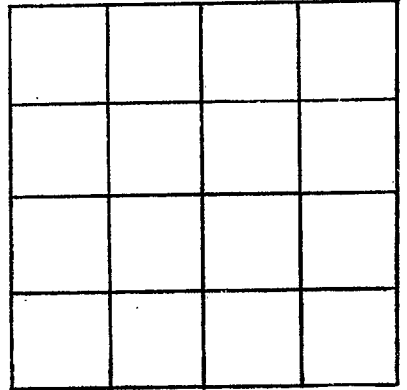

SECTION _____

Please indicate well location X.

ADDITIONAL INFORMATION

If more than one screen, show locations of each on sketch.