

Marion
 J 28
 6-20-69

MISSISSIPPI
 BOARD OF WATER COMMISSIONERS
 416 North State Street
 Jackson, Mississippi 39201

CODED

WATER WELL DRILLERS LOG

6/20/69 19 Dean Striner Marion
 date well completed firm name county well located

LANDOWNER: ~~_____~~
Joyie Summers
Route 1 Kokomo, Miss.
 (mailing address)

description of formations encountered	from	to
<u>Top soil</u>	<u>0</u>	<u>1</u>
<u>Red Clay</u>	<u>1</u>	<u>20</u>
<u>Gravel</u>	<u>20</u>	<u>65</u>
<u>Chalk</u>	<u>65</u>	<u>110</u>
<u>fine sand</u>	<u>110</u>	<u>120</u>
<u>Coarse water sand</u>	<u>130</u>	<u>150</u>

WELL LOCATION:
 sec. 7 T E N 12 S R 12 W
4 miles N of Kokomo
 (distance) (direction) (nearest town)

WELL PURPOSE: Home Use
 (home, irrigation, municipal, industrial)

- WELL COMPLETION DATA:
- (1) diameter (inches) 4"
 - (2) total depth (feet) 150'
 - (3) static water level (feet) _____ below above top of ground.
 - (4) casing Plastic, 140'
 (material) (depth)
 _____ if telescope see back.
 (size)
 - (5) screen 10', 140'
 (length) (depth to top)
4", Plastic
 (size) (material)
 - (6) pump 3/4 H.P.
 (HP) (yield gpm)
Jacuzzi sub. pump
 (type power)
 - (7) electric log No
 (yes or no)

 (organization running log)
 - (8) how well bottom plugged _____

CODED


MAR 18 1970

MISS. BD. OF
 WATER COMM.

DRILLERS REMARKS:

If well telescopes please sketch and show depths.

GROUND LEVEL

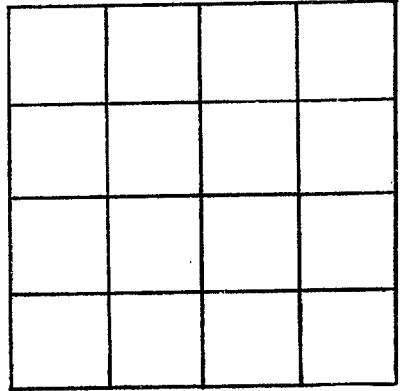

SECTION _____

Please indicate well location X.

ADDITIONAL INFORMATION

If more than one screen, show locations of each on sketch.