

Marion
 J 29
 10-16-69

MISSISSIPPI
 BOARD OF WATER COMMISSIONERS
 416 North State Street
 Jackson, Mississippi 39201

CODED

WATER WELL DRILLERS LOG

10/16 1969 Dean Griner Marion
 date well completed firm name county well located

LANDOWNER:
 Fred Rowley
 Route 1 Bohannon, Miss.
 (mailing address)

description of formations encountered	from	to
top soil	0	1
Red Clay	1	55
Gravel	55	90
Chalk	90	120
Water sand	120	145

WELL LOCATION:
 sec. 16 T2 R12 S
 3 miles North of Bohannon
 (distance) (direction) (nearest town)

WELL PURPOSE: Home Use
 (home, irrigation, municipal, industrial)

WELL COMPLETION DATA:

(1) diameter (inches) 4"

(2) total depth (feet) 145'

(3) static water level (feet) _____ below/above top of ground.

(4) casing Plastic, 135'
 (material) (depth)

_____ if telescope see back.
 (size)

(5) screen 10' , 135'
 (length) (depth to top)
 4" , Plastic
 (size) (material)

(6) pump 1/2 HP, _____
 (HP) (yield gpm)
 M-Donald sub, Pump
 (type power)

(7) electric log NO
 (yes or no)

_____ (organization running log)

(8) how well bottom plugged _____

CODED


MAR 18 1970

MISS. BD. OF
 WATER COMM.

DRILLERS REMARKS:

If well telescopes please sketch and show depths.

GROUND LEVEL

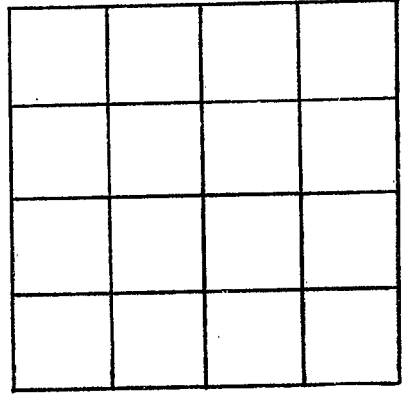

SECTION _____

Please indicate well location X.

ADDITIONAL INFORMATION

If more than one screen, show locations of each on sketch.