

MARION  
J 30  
12-69

MISSISSIPPI  
BOARD OF WATER COMMISSIONERS  
416 North State Street  
Jackson, Mississippi 39201

**CODED**

WATER WELL DRILLERS LOG

Feb. 1969 E.B. Sherrard Marion  
date well completed firm name county well located

LANDOWNER:	description of formations encountered	from	to
Olinas Summers Kokomo, Miss. (mailing address)	GRAY CLAY COARSE SAND GRAVEL & FINE SAND PIECE GRAVEL	0	40 60 130 162
WELL LOCATION: sec. 26 T 30 N R 20 E 9 miles SW of Columbia (distance) (direction) (nearest town)			
WELL PURPOSE: (home, irrigation, municipal, industrial)			
WELL COMPLETION DATA: (1) diameter (inches) 4" (2) total depth (feet) 162 (3) static water level (feet) 40 below above top of ground. (4) casing Plastic, 162, (material) (depth) 4" If telescope see back. (size) (5) screen 10' (length) (depth to top) 4" Plastic (size) (material) (6) pump 1 (HP) 29 (yield gpm) (type power) (7) electric log (yes or no) (organization running log) (8) how well bottom plugged B.V.			
DRILLERS REMARKS:			


**CODED**

FEB 5 - 1970

MISS. Bd. of  
WATER COMMISSIONERS

If well telescopes please sketch and show depths.

GROUND LEVEL

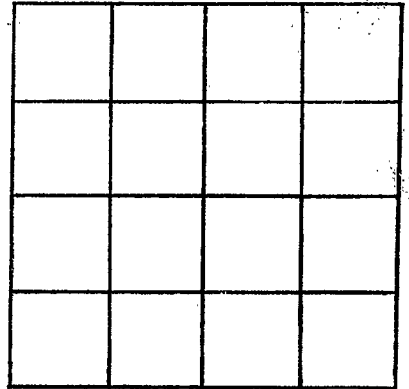

SECTION \_\_\_\_\_

Please indicate well location X.

ADDITIONAL INFORMATION

If more than one screen, show locations of each on sketch.