

Marion
J 31
1-19-70

MISSISSIPPI
BOARD OF WATER COMMISSIONERS
416 North State Street
Jackson, Mississippi 39201

CODED

WATER WELL DRILLERS LOG

1/19 1970 Dean Grimes Marion
date well completed firm name county well located

LANDOWNER:

Kokomo Bapt. Church.
Kokomo, Miss.
(mailing address)

description of formations encountered

from to

| | |
|-------------------|----------|
| top soil | 0-1 |
| Red Clay | 1-5 |
| Chalk | 5-2.5 |
| Gravel | 2.5-6.0 |
| fine white sand | 6.0-8.5 |
| Coarse water sand | 8.5-10.5 |

WELL LOCATION:

sec. 28 T3 N S R-12 E
miles of Kokomo
(distance) (direction) (nearest town)

WELL PURPOSE: Church Well
(home, irrigation, municipal, industrial)

WELL COMPLETION DATA:

- (1) diameter (inches) 4"
- (2) total depth (feet) 105'
- (3) static water level (feet) _____ below/above top of ground:
- (4) casing Plastic 95'
(material) (depth)
- _____ if telescope see back.
(size)
- (5) screen 10' 95'
(length) (depth to top)
- 4" Plastic
(size) (material)
- (6) pump _____ (HP) _____ (yield gpm)
Used old pump
(type power)
- (7) electric log 100
(yes or no)
- _____ (organization running log)
- (8) how well bottom plugged _____

CODED


MAR 18 1970

MISS. BD. OF
WATER COMM.

DRILLERS REMARKS:

If well telescopes please sketch and show depths.

GROUND LEVEL

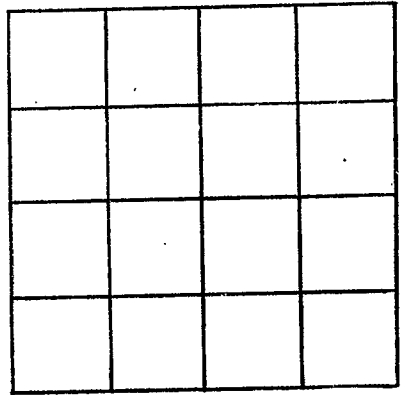

SECTION _____

Please indicate well location X.

ADDITIONAL INFORMATION

If more than one screen, show locations of each on sketch.