

Marion
J 34
2-5-70

MISSISSIPPI
BOARD OF WATER COMMISSIONERS
416 North State Street
Jackson, Mississippi 39201

COPIED

WATER WELL DRILLERS LOG

2/5 1970 Dean Sines Marion
date well completed firm name county well located

LANDOWNER:

Eugene Summert
Route 2 Popworth, Miss.
(mailing address)

description of formations encountered

from to

Top soil 0-1

Red Clay 1-15

Gravel 15-65

Chalk 65-80

fine sand 80-100

Coarse water sand 100-120

WELL LOCATION:

sec 26 T 3 N R 12 E
S W
8 miles S of Popworth
(distance) (direction) (nearest town)

WELL PURPOSE: Home Use
(home, irrigation, municipal, industrial)

WELL COMPLETION DATA:

(1) diameter (inches) 4"

(2) total depth (feet) 120'

(3) static water level (feet) 83' below above top of ground.

(4) casing Plastic 110'
(material) (depth)

(size) If telescope see back.

(5) screen 10' 110'
(length) (depth to top)

4" Plastic
(size) (material)

(6) pump 1/4
(HP) (yield gpm)

McDonald sub pump
(type power)

(7) electric log No
(yes or no)

(organization running log)

(8) how well bottom plugged

COPIED


MAR 18 1970

MISS. BD. OF
WATER COM.:

DRILLERS REMARKS:

If well telescopes please sketch and show depths.

GROUND LEVEL

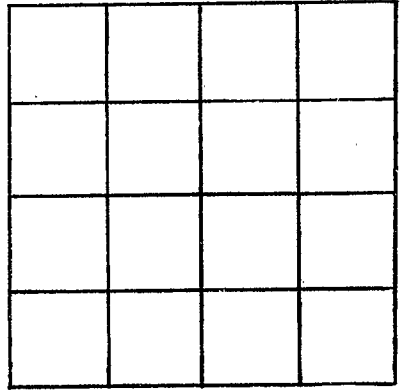

SECTION _____

Please indicate well location X.

ADDITIONAL INFORMATION

If more than one screen, show locations of each on sketch.