

Marion
J 35
2-70

MISSISSIPPI
BOARD OF WATER COMMISSIONERS
416 North State Street
Jackson, Mississippi 39201

CODED


WATER WELL DRILLERS LOG

FEB. 1970 E.B. SHEPPARD MARION
date well completed firm name county well located

LANDOWNER:	description of formations encountered	from	to
HERBERT OTIS Rt. 1 - Foxworth, Miss. (mailing address)	RED SANDY CLAY SAND & GRAVEL	0	45 58
<p>WELL LOCATION:</p> <p>sec. 10 T. 3 (N) R. 12 (E) S W</p> <p>8 miles W of COLUMBIA (distance) (direction) (nearest town)</p>			
<p>WELL PURPOSE:</p> <p>(home) irrigation, municipal, industrial</p>			
<p>WELL COMPLETION DATA:</p> <p>(1) diameter (inches) 2"</p> <p>(2) total depth (feet) 58</p> <p>(3) static water level (feet) 49 <input checked="" type="checkbox"/> below <input type="checkbox"/> above top of ground.</p> <p>(4) casing PL. 58 (material) (depth) 2" if telescope see back. (size)</p> <p>(5) screen 3' (length) (depth to top) 2 1/2" S.S. (size) (material)</p> <p>(6) pump 3/4 6 (HP) (yield gpm) E (type power)</p> <p>(7) electric log <input checked="" type="checkbox"/> (yes or no) (organization running log)</p> <p>(8) how well bottom plugged B.W.V.</p>			
<p>DRILLERS REMARKS:</p> <p style="text-align: right;">MISS. BD. OF WATER COMM.</p> <p style="text-align: center;">MAR 17 1970</p>			

If well telescopes please sketch and show depths.

GROUND LEVEL

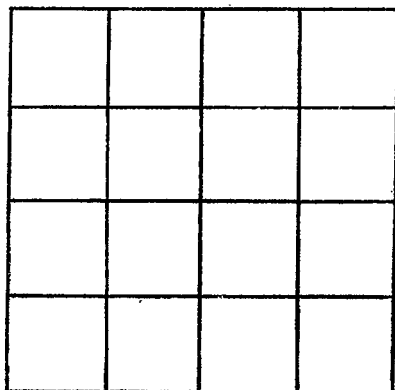

SECTION _____

Please indicate well location X.

ADDITIONAL INFORMATION

If more than one screen, show locations of each on sketch.