

MISSISSIPPI  
BOARD OF WATER COMMISSIONERS  
416 North State Street  
Jackson, Mississippi 39201

**CODED**

WATER WELL DRILLERS LOG

MARION  
J 37  
8-70

August 1970 E. B. SHERROD MARION  
date well completed firm name county well located


LANDOWNER:	description of formations encountered	from	to
HOMER COWART Rt. 1 - Kokomo, Miss. (mailing address)	RED SANDY CLAY MIXED WITH GRAVEL	0	50'
WELL LOCATION: sec. 17 T. 3 N. R. 12 E. 8 miles W of FOXWORTH (distance) (direction) (nearest town)	MOSTLY GRAVEL SMALL PEAS GRAVEL	50	75' 75 110'
WELL PURPOSE: (home, irrigation, municipal, industrial)			
WELL COMPLETION DATA:	<b>CODED</b>		
(1) diameter (inches) 2"			
(2) total depth (feet) 110			
(3) static water level (feet) 75' below top of ground.			
(4) casing GALV. IRON 107' (material) (depth)			
2" (size) if telescope see back.			
(5) screen 3' (length) (depth to top)			
2" (size) SS (material)			
(6) pump ROD PUMP 4 1/2 (HP) (yield gpm)			
E (type power)			
(7) electric log (yes or no)			
(organization running log)			
(8) how well bottom plugged BWV			
DRILLERS REMARKS:			

OCT 19 1970

MISSISSIPPI  
BOARD OF WATER COMMISSIONERS  
416 NORTH STATE STREET  
JACKSON, MISSISSIPPI 39201

If well telescopes please sketch and show depths.

GROUND LEVEL

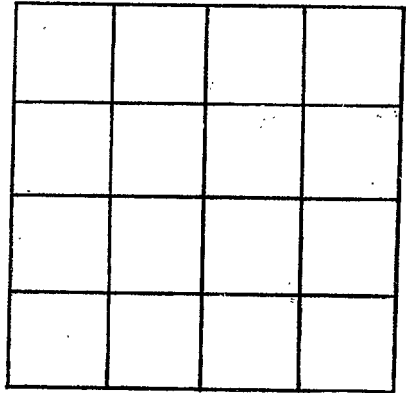

SECTION \_\_\_\_\_

Please indicate well location X.

ADDITIONAL INFORMATION

Lined area for additional information.

If more than one screen, show locations of each on sketch.