

MISSISSIPPI
BOARD OF WATER COMMISSIONERS
416 North State Street
Jackson, Mississippi 39201

CODED

WATER WELL DRILLERS LOG

MARION
J 38
9-70

SEPT. 1970 E.B. SHERRARD MARION
date well completed firm name county well located


LANDOWNER:	description of formations encountered	from	to
<p><u>Mrs. BILL REYERS</u> <u>Kokomo, Miss-</u> (mailing address)</p>	<p><u>RED SANDY</u> <u>CLAY</u> <u>SAND</u> <u>RED CLAY</u> <u>PIEA GRAVEL</u></p>	<p><u>0</u> <u>50</u> <u>70</u> <u>70</u> <u>90</u></p>	<p><u>50</u> <u>70</u> <u>90</u> <u>110</u></p>
<p>WELL LOCATION: sec <u>30</u> T <u>3</u> N R <u>12</u> E S W <u>10</u> miles <u>W</u> of <u>Foxworth</u> (distance) (direction) (nearest town)</p>			
<p>WELL PURPOSE: (<u>home</u>, irrigation, municipal, industrial)</p>			
<p>WELL COMPLETION DATA:</p> <p>(1) diameter (inches) <u>2"</u></p> <p>(2) total depth (feet) <u>110</u></p> <p>(3) static water level (feet) <u>65</u> below above top of ground.</p> <p>(4) casing <u>PL.</u> <u>107</u> (material) (depth)</p> <p><u>2"</u> if telescope see back. (size)</p> <p>(5) screen <u>3'</u> <u>S.S.</u> (length) (depth to top) (size) (material)</p> <p>(6) pump <u>3/4</u> <u>7</u> (HP) (yield gpm)</p> <p><u>E</u> (type power)</p> <p>(7) electric log (yes or <u>no</u>)</p> <p>(organization running log)</p> <p>(8) how well bottom plugged <u>BWV</u></p>	<p>CODED</p>		
<p>DRILLERS REMARKS:</p>			

OCT 19 1970

MISS. BD. OF
WATER COMMISSIONERS

If well telescopes please sketch and show depths.

GROUND LEVEL

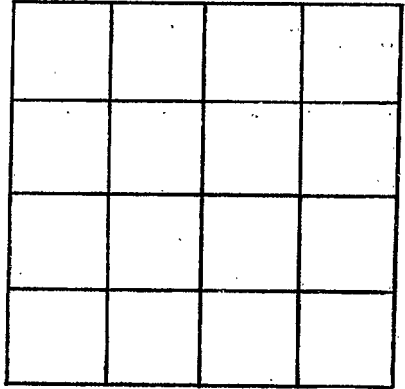

SECTION _____

Please indicate well location X.

ADDITIONAL INFORMATION

Lined area for additional information.

If more than one screen, show locations of each on sketch.