

MARION
 J 40
 11-70

MISSISSIPPI
 BOARD OF WATER COMMISSIONERS
 416 North State Street
 Jackson, Mississippi 39201

CODED

WATER WELL DRILLERS LOG

Nov. 1970 E. B. SHERRARD MARION
 date well completed firm name county well located

LANDOWNER:
 A. B. BULLOCK
 Rt. 1 - Kokomo, Miss.
 (mailing address)

description of formations encountered	from	to
FINE RED CLAY	0	25'
SANDY RED CLAY	25'	60'
SAND & LOOSE GRAVEL	60'	84'
HARD RED CLAY BASE		

WELL LOCATION:
 sec. 10 T. 3 N R. 12 E
 S W
 8 miles W of COLUMBIA
 (distance) (direction) (nearest town)

WELL PURPOSE:
 (home, irrigation, municipal, industrial)

WELL COMPLETION DATA:

(1) diameter (inches) 2"

(2) total depth (feet) 84'

(3) static water level (feet) 66 below top of ground.

(4) casing DL, 79 (material), (depth)
 2" (size) if telescope see back.

(5) screen 5 (length), (depth to top)
 2" (size), S.S. (material)

(6) pump L-H.P. 6 (HP), (yield gpm)
 E (type power)

(7) electric log (yes or no)

(organization running log)

(8) how well bottom plugged B.W.V

CODED


FEB 7 1971

MISS. BD. OF WATER COMMISSIONERS

DRILLERS REMARKS:

If well telescopes please sketch and show depths.

GROUND LEVEL

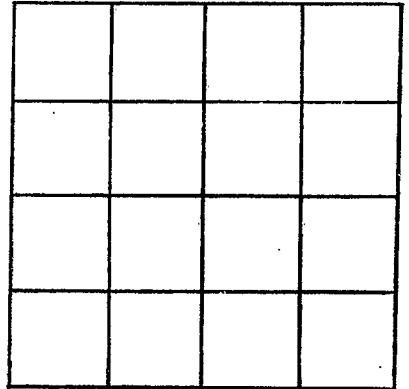

SECTION _____

Please indicate well location X.

ADDITIONAL INFORMATION

If more than one screen, show locations of each on sketch.