

MARION
 J 41
 1-26-71

MISSISSIPPI
 BOARD OF WATER COMMISSIONERS
 416 North State Street
 Jackson, Mississippi 39201

CODED

WATER WELL DRILLERS LOG

1-26 19 71 Fitzgerald Well Co Marion
 date well completed firm name county well located

LANDOWNER: D. J. Mayo
P.O. Box 116
 (mailing address)

description of formations encountered	from	to
Red clay	6	20
Red sand	20	130
Red gravel	130	140
Fine sand	140	180
Coarse sand & gravel	180	198

WELL LOCATION:
 sec. 35 T 3N R 12E
6 miles SE of Kaloma
 (distance) (direction) (nearest town)

WELL PURPOSE: flow
 (home, irrigation, municipal, industrial)

- WELL COMPLETION DATA:
- (1) diameter (inches) 4
 - (2) total depth (feet) 198
 - (3) static water level (feet) 170 below top of ground.
 - (4) casing plastic 190
 (material) (depth)
4 if telescope see back.
 (size)
 - (5) screen 8 190
 (length) (depth to top)
4 plastic
 (size) (material)
 - (6) pump 3/4 8
 (HP) (yield gpm)
El.
 (type power)
 - (7) electric log no
 (yes or no)
 (organization running log)
 - (8) how well bottom plugged Washed

CODED


FEB 11 1971

MISS. BD. OF
 WATER COMM.

DRILLERS REMARKS:

If well telescopes please sketch and show depths.

GROUND LEVEL

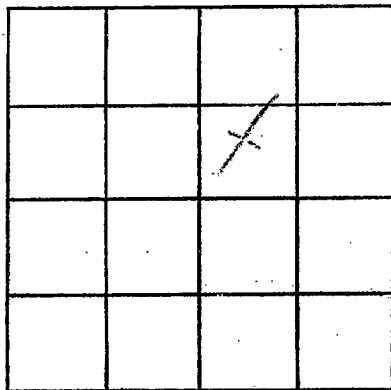

SECTION 25

Please indicate well location X.

ADDITIONAL INFORMATION

If more than one screen,
show locations of each on sketch.