

MARION  
 J42 ~~1125~~  
 1-71

MISSISSIPPI  
 BOARD OF WATER COMMISSIONERS  
 416 North State Street  
 Jackson, Mississippi 39201  
 WATER WELL DRILLERS LOG

**CODED**

JAN 1971 71 E. B. SHERRARD MARION  
 date well completed firm name county well located

LANDOWNER:

J. A. GRAHAM

description of formations encountered

from to

Pt. 1 - Kokomo, Miss

(mailing address)

RED SANDY CLAY  
 DEEP GRAVEL  
 BLUE CLAY  
 FINE SAND  
 DEEP GRAVEL

0 22'  
 22 28'  
 28 70'  
 70 88'  
 88 97'

WELL LOCATION:

sec. 13 T. 3 N. R. 0 E S  
 4 miles W of FOXWORTH  
 (distance) (direction) (nearest town)

WELL PURPOSE:

(home) irrigation, municipal, industrial

WELL COMPLETION DATA:

- (1) diameter (inches) 2"
- (2) total depth (feet) 97
- (3) static water level (feet) 13  below  above top of ground.
- (4) casing PL, 90', (material) (depth)  
 2" (size) if telescope see back.
- (5) screen 25', (length) (depth to top)  
 2" (size), PL (material)
- (6) pump 1/3 (HP), 9 (yield gpm)  
 F (type power)
- (7) electric log  yes  no

(organization running log)

(8) how well bottom plugged BWV

DRILLERS REMARKS:


**CODED**

FEB 1 1971

MISS. BD. OF  
 WATER COMM.

If well telescopes please sketch and show depths.

GROUND LEVEL

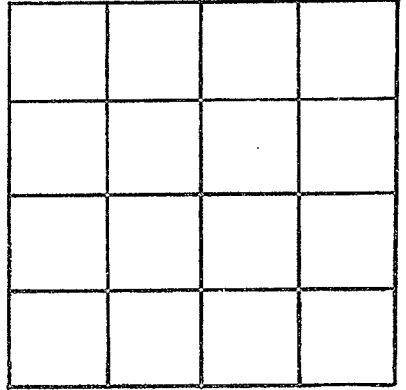

SECTION \_\_\_\_\_

Please indicate well location X.

ADDITIONAL INFORMATION

If more than one screen, show locations of each on sketch.