

MARION
543
2-11-71

MISSISSIPPI
BOARD OF WATER COMMISSIONERS
416 North State Street
Jackson, Mississippi 39201

CODED

WATER WELL DRILLERS LOG

2-11-71 date well completed
Dean Shivers Well Service firm name
Marion county well located

LANDOWNER:
Winifred M^cKenzie
Route 1 Popworth, Miss.
(mailing address)

description of formations encountered	from	to
top soil	0	2'
Chalk	2	150'

WELL LOCATION:
sec. 12 T 3 N R 12 W
12 miles West of Columbia
(distance) (direction) (nearest town)

Water Sand	150	200
------------	-----	-----

WELL PURPOSE: Home Well
(home, irrigation, municipal, industrial)

- WELL COMPLETION DATA:
- (1) diameter (inches) 2"
 - (2) total depth (feet) 200'
 - (3) static water level (feet) 135' below top of ground.
 - (4) casing Galv. Pipe, 194' (material) (depth)
 - (size) If telescope see back.
 - (5) screen 4' 196' (length) (depth to top)
 - 2" Stainless steel (size) (material)
 - (6) pump H.A.B. (HP) (yield gpm)
 - (type power)
 - (7) electric log No (yes or no)
 - (organization running log)
 - (8) how well bottom plugged

CODED


MAR 19 1971

DRILLERS REMARKS:

MISS. BD. OF
WATER COMMISSIONERS

If well telescopes please sketch and show depths.

GROUND LEVEL

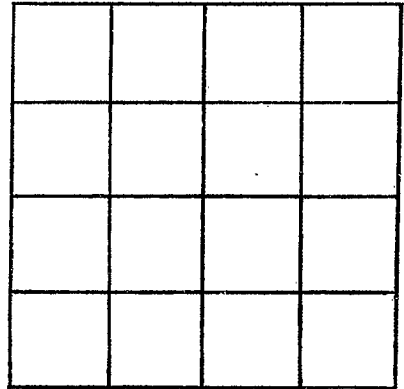

SECTION _____

Please indicate well location X.

ADDITIONAL INFORMATION

If more than one screen,
show locations of each on sketch.