

MARION
 544
 4-19-71

MISSISSIPPI
 BOARD OF WATER COMMISSIONERS
 416 North State Street
 Jackson, Mississippi 39201

CODED

WATER WELL DRILLERS LOG

4-19-71 date well completed
 Dean Trines Drilling Co firm name
 Marion county well located

LANDOWNER:
 Alton Beard
 Route 1 Kokomo, Miss.
 (mailing address)

| description of formations encountered | from | to |
|---------------------------------------|------|-----|
| top soil | 0 | 1 |
| red clay | 1 | 15 |
| gravel | 15 | 60 |
| fine sand | 60 | 110 |
| water sand | 110 | 146 |

WELL LOCATION:
 sec. 19 T 2 N R 12 E
 4 miles S W of Kokomo
 (distance) (direction) (nearest town)

WELL PURPOSE: home use
 (home, irrigation, municipal, industrial)

- WELL COMPLETION DATA:
- (1) diameter (inches) 2"
 - (2) total depth (feet) 146
 - (3) static water level (feet) 50' below above top of ground.
 - (4) casing plastic, 137' (material) (depth)
 (size) If telescope see back.
 - (5) screen 7' length, 139' depth to top
 2" plastic (size) (material)
 - (6) pump 1 (HP) (yield gpm)
 (type power)
 - (7) electric log (yes or no)
 (organization running log)
 - (8) how well bottom plugged

CODED


APR 28 1971

DRILLERS REMARKS:

MISS. BD. OF
 WATER COMM.

If well telescopes please sketch and show depths.

GROUND LEVEL

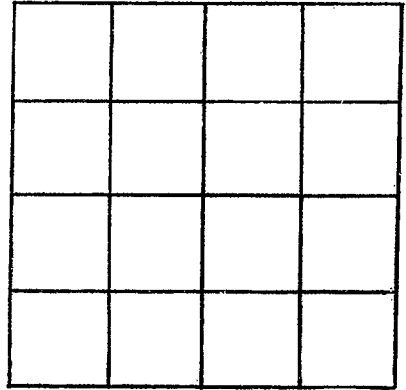

SECTION _____

Please indicate well location X.

ADDITIONAL INFORMATION

If more than one screen, show locations of each on sketch.