

MARION  
J45  
5-4-71

MISSISSIPPI  
BOARD OF WATER COMMISSIONERS  
416 North State Street  
Jackson, Mississippi 39201

**CODED**

WATER WELL DRILLERS LOG

5/4/71 date well completed  
Hess Drilling Well Service firm name  
Marion county well located

LANDOWNER:  
Dale Roberts  
Route 1 Kibona, Miss.  
(mailing address)

description of formations encountered	from	to
Top soil	0	1
Chalk	1	27

WELL LOCATION:  
sec 13 T 20 N R 12 E S  
12 miles SW of Columbia  
(distance) (direction) (nearest town)

Water sand	27	90
------------	----	----

WELL PURPOSE: House use  
(home, irrigation, municipal, industrial)

- WELL COMPLETION DATA:
- (1) diameter (inches) 2"
  - (2) total depth (feet) 90'
  - (3) static water level (feet) 8' below above top of ground.
  - (4) casing Plastic 81'  
(material) (depth)  
(size) If telescope see back.
  - (5) screen 7' 8'  
(length) (depth to top)  
2" Plastic  
(size) (material)
  - (6) pump 1/2 H.P.  
(HP) (yield gpm)  
(type power)
  - (7) electric log \_\_\_\_\_  
(yes or no)  
(organization running log)
  - (8) how well bottom plugged \_\_\_\_\_

**CODED**


MAY 19 1971

DRILLERS REMARKS:

MISS. Bd. OF  
WATER COMMISSIONERS

If well telescopes please sketch and show depths.

GROUND LEVEL

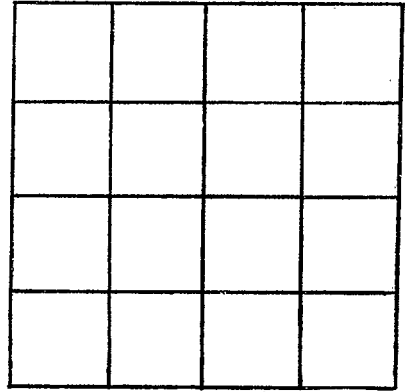

SECTION \_\_\_\_\_

Please indicate well location X.

ADDITIONAL INFORMATION

A series of horizontal lines for recording additional information.

If more than one screen, show locations of each on sketch.