

MARION
 J 46
 7-31-71

MISSISSIPPI
 BOARD OF WATER COMMISSIONERS
 416 North State Street
 Jackson, Mississippi 39201

CODED

WATER WELL DRILLERS LOG

7-31-71 date well completed
 Dean Davis Water well firm name
 Marion county well located

LANDOWNER:
 Jimmie Statham
 Route 2, Florworth Miss
 (mailing address)

description of formations encountered	from	to
top soil	0	1
red clay	1	10
sand & gravel	10	80
Chalk	80	90
sand & gravel	90	120
Water sand	120	195

WELL LOCATION:
 sec 35 T 30 N R 12E
 3 miles E of Vicksburg
 (distance) (direction) (nearest town)

WELL PURPOSE: Home Use
 (home, irrigation, municipal, industrial)

- WELL COMPLETION DATA:
- (1) diameter (inches) 2"
 - (2) total depth (feet) 185'
 - (3) static water level (feet) 120' below top of ground.
 - (4) casing Plastic 176' (material) (depth)
 (size) if telescope see back.
 - (5) screen 7' 178' (length) (depth to top)
 2" Plastic (size) (material)
 - (6) pump 2 (HP) (yield gpm)
 (type power)
 - (7) electric log (yes or no)
 (organization running log)
 - (8) how well bottom plugged

CODED


JUL 8 1971

MISS. BD. OF
 WATER COMM.

DRILLERS REMARKS:

If well telescopes please sketch and show depths.

GROUND LEVEL

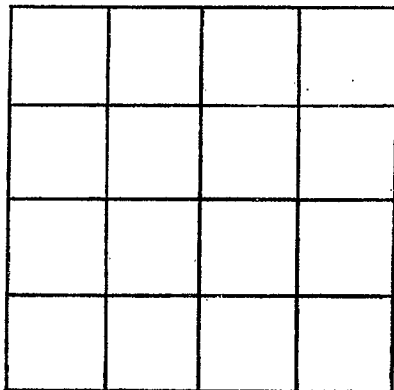

SECTION _____

Please indicate well location X.

ADDITIONAL INFORMATION

If more than one screen, show locations of each on sketch.