

Marion
J-47
6-71

MISSISSIPPI
BOARD OF WATER COMMISSIONERS
416 North State Street
Jackson, Mississippi 39201

WATER WELL DRILLERS LOG

CODED

JUNE
date well completed

19 71 F. B. SHEPPARD
firm name

MARION
county well located

LANDOWNER:

WILBER MCGOWAN
FOXWORTH
(mailing address)

description of formations
encountered

SANDY RED
GRAVEL

from

to

0 40
40 54

WELL LOCATION:

sec. 11 T. 3^N R. 20^E
S
7 miles W of Columbia
(distance) (direction) (nearest town)

WELL PURPOSE:

(home) irrigation, municipal, industrial

WELL COMPLETION DATA:

- (1) diameter (inches) 2"
(2) total depth (feet) 54
(3) static water level (feet) 42 below
top of ground.
(4) casing PL, 49
(material) (depth)
2"
(size) If telescope see back.
(5) screen 5',
(length) (depth to top)
2", PL
(size) (material)
(6) pump 3/4, 5
(HP) (yield gpm)
E
(type power)
(7) electric log _____
(yes or no)
(organization running log)
(8) how well bottom plugged BWV

CODED


SEP 15 1971

MISS. DD. OF
WATER COMM.

DRILLERS REMARKS:

If well telescopes please sketch and show depths.

GROUND LEVEL

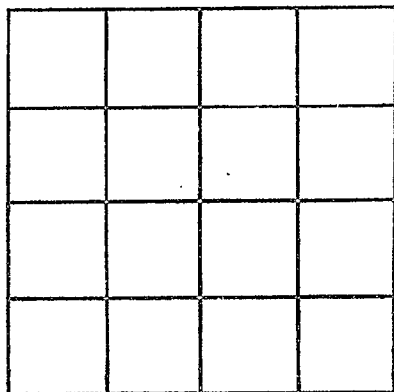

SECTION _____

Please indicate well location X.

ADDITIONAL INFORMATION

If more than one screen, show locations of each on sketch.