

Marion  
J-48  
7-71

MISSISSIPPI  
BOARD OF WATER COMMISSIONERS  
416 North State Street  
Jackson, Mississippi 39201

WATER WELL DRILLERS LOG

**CODED**

July  
date well completed

1971 F.B. SHERKARD  
firm name

Marion  
county well located

LANDOWNER:

WILLIE BRISTER

Rt 2 - TYLERTOWN  
(mailing address)

WELL LOCATION:

sec 17 T-30 N R 12 E  
S W  
11 miles W of Columbia  
(distance) (direction) (nearest town)

WELL PURPOSE:

(Home) Irrigation, municipal, industrial

WELL COMPLETION DATA:

- (1) diameter (inches) 2"  
(2) total depth (feet) 102  
(3) static water level (feet) 70 below above top of ground.  
(4) casing PL 97 (material) (depth)  
2" (size) if telescope see back.  
(5) screen 5' (length) (depth to top)  
2" PL (size) (material)  
(6) pump 3/4 6 (HP) (yield gpm)  
E (type power)  
(7) electric log (yes or no)  
(organization running log)  
(8) how well bottom plugged BWV

description of formations encountered

	from	to
RED GRAVEL CLAY	0	40'
INCONSISTENT LAYERING	40'	90'
PIEA GRAVEL	90'	102'

**CODED**


SEP 15 1971

MISS. BD. OF  
WATER COMMISSIONERS

DRILLERS REMARKS:

If well telescopes please sketch and show depths.

GROUND LEVEL

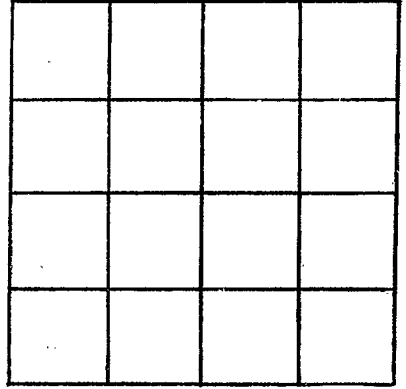

SECTION \_\_\_\_\_

Please indicate well location X.

ADDITIONAL INFORMATION

If more than one screen,  
show locations of each on sketch.