

MISSISSIPPI  
BOARD OF WATER COMMISSIONERS  
416 North State Street  
Jackson, Mississippi 39201

WATER WELL DRILLERS LOG

MARION  
J49  
10-71

OCT. 1971 E.B. SHEPPARD  
date well completed firm name

CODED  
County Well Located

LANDOWNER:

DWIGHT STEWART  
Rt. 1 - Kokomo, Miss.  
(mailing address)

description of formations encountered

RED CLAY BR. 0' 40'  
SAND & GRAVEL 40' 69'

from to

WELL LOCATION:

sec 24 T 3 N R 12 E  
4 miles W of Foxworth  
(distance) (direction) (nearest town)

WELL PURPOSE:

(home irrigation, municipal, industrial)

WELL COMPLETION DATA:

- (1) diameter (inches) 4"
- (2) total depth (feet) 69
- (3) static water level (feet) 49 below top of ground.
- (4) casing PL. 59 (material) (depth)  
4" (size) if telescope see back.
- (5) screen 10' (length) (depth to top)  
4" (size) PL. (material)
- (6) pump 1/2 (HP) 15 (yield gpm)  
E (type power)
- (7) electric log (yes or no)
- (organization running log)
- (8) how well bottom plugged RNV

CODED


FEB 2 1972

DRILLERS REMARKS:

MISS. BD. OF  
WATER COM. REG.

If well telescopes please sketch and show depths.

GROUND LEVEL

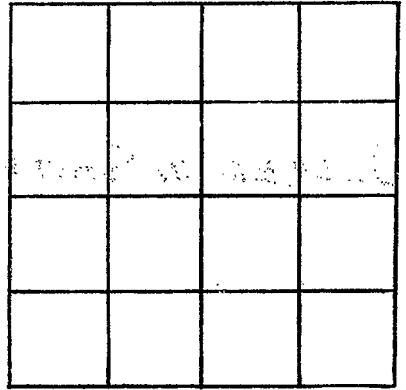

SECTION \_\_\_\_\_

Please indicate well location X.

ADDITIONAL INFORMATION

If more than one screen,  
show locations of each on sketch.