

MARION
 J 51
 9-10-71

MISSISSIPPI
 BOARD OF WATER COMMISSIONERS FEB - 7 1972
 416 North State Street
 Jackson, Mississippi 39201

WATER WELL DRILLERS LOG

CODED

20 25

9-10
 date well completed


71 Dean Grimes Drilling Service Marion
 firm name county well located

LANDOWNER:	description of formations encountered	from	to
J. D. Dillon			
Rt. 2 Foxworth, Miss. (mailing address)	top soil	0	1'
WELL LOCATION:	gravel	1	27'
sec. 34 T. 3 N R. 12 E	clay	27	35'
12 miles S.W. of Columbia (distance) (direction) (nearest town)	tan Chalk	35	48'
WELL PURPOSE: Home (home, irrigation, municipal, industrial)	sand & gravel	48	65'
WELL COMPLETION DATA:	fine sand	65	73'
(1) diameter (inches) 2"	water sand	73	85'
(2) total depth (feet) 85'			
(3) static water level (feet) 45' below top of ground			
(4) casing (material) Plastic, (depth) 73'			
(size) If telescope see back.			
(5) screen (length) 10', (depth to top) 75'			
(size) 2, (material) Plastic			
(6) pump 3/4 (HP), (yield gpm)			
(type power)			
(7) electric log (yes or no)			
(organization running log)			
(8) how well bottom plugged			
DRILLERS REMARKS:			

CODED

If well telescopes please sketch and show depths.

GROUND LEVEL

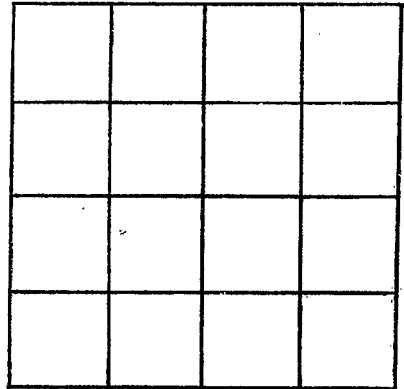

SECTION _____

Please indicate well location X.

ADDITIONAL INFORMATION

If more than one screen,
show locations of each on sketch.