

MARION
 QJ52
 10-27-71

MISSISSIPPI
 BOARD OF WATER COMMISSIONERS
 416 North State Street
 Jackson, Mississippi 39201

FEB - 7 1972

MISS. BD. OF

WATER WELL DRILLERS LOG

10-27-1971 date well completed
 Dean Miner Drilling firm name
 Marion county well located

CODED

LANDOWNER:
 Willard Oliver
 Rt 1 Kokomo, Miss.
 (mailing address)

description of formations encountered	from	to
top soil	0	1'
clay	1	7'
gravel	7	23'
chalk	23	68'
sand & gravel	68	80'
fine sand	80	99'
water sand	99	130'

WELL LOCATION:
 sec 27 T-3 N R 12 E
 10 miles S.W. of Columbia
 (distance) (direction) (nearest town)

WELL PURPOSE: Home
 (home, irrigation, municipal, industrial)

WELL COMPLETION DATA:

(1) diameter (inches) 4"

(2) total depth (feet) 130'

(3) static water level (feet) 75' below above top of ground.

(4) casing Plastic 120'
 (material) (depth)
 (size) If telescope see back.

(5) screen 10' 120'
 (length) (depth to top)
 4" Plastic
 (size) (material)

(6) pump 3/4
 (HP) (yield gpm)
 (type power)

(7) electric log (yes or no)
 (organization running log)


(8) how well bottom plugged

CODED

DRILLERS REMARKS:

If well telescopes please sketch and show depths.

GROUND LEVEL

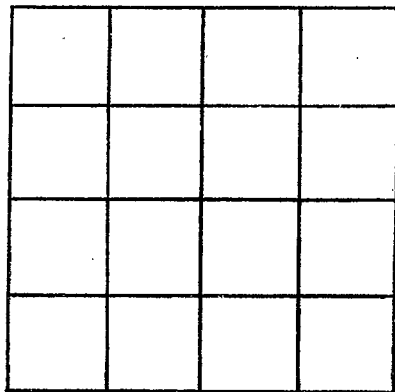

SECTION _____

Please indicate well location X.

ADDITIONAL INFORMATION

If more than one screen, show locations of each on sketch.