

MARION
J55
2-72

MISSISSIPPI
BOARD OF WATER COMMISSIONERS
416 North State Street
Jackson, Mississippi 39201

WATER WELL DRILLERS LOG

CODED

FEB. 1972 E.B. SHEPARD MARION
date well completed firm name county well located

LANDOWNER:	description of formations encountered	from	to
DAVID HILL FOXWORTH Miss (mailing address)	RED CLAY MIXED SAND & GRAVEL & CLAY LOOSE GRAVEL	0 30 90 90	30 90 105
WELL LOCATION: sec 20 T 3 N S R 12 E W 10 miles W of Columbus (distance) (direction) (nearest town)			
WELL PURPOSE: (home, irrigation, municipal, industrial)			
WELL COMPLETION DATA: (1) diameter (inches) 2" (2) total depth (feet) 105 (3) static water level (feet) 97 below above top of ground. (4) casing PL 100 (material) (depth) 2" (size) if telescope see back. (5) screen 5' (length) (depth to top) 2" PL (size) (material) (6) pump 1 8 (HP) (yield gpm) E (type power) (7) electric log (yes or no) (organization running log) (8) how well bottom plugged BWV			
DRILLERS REMARKS:			


CODED

MAR 26 1972

REC'D OF
WATER COMM.

If well telescopes please sketch and show depths.

GROUND LEVEL

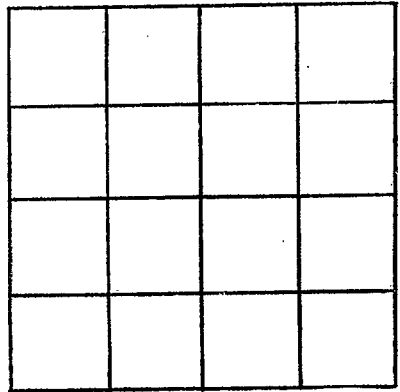

SECTION _____

Please indicate well location X.

ADDITIONAL INFORMATION

If more than one screen, show locations of each on sketch.