

MARION  
J 60  
10-3-73

MISSISSIPPI  
BOARD OF WATER COMMISSIONERS  
416 North State Street  
Jackson, Mississippi 39201

**CODED**

WATER WELL DRILLERS LOG

10/3 1973 GRINER-GINN MARION  
date well completed firm name county well located

LANDOWNER: Louis Holman  
Rt #1  
Kokomo, Miss  
(mailing address)

description of formations encountered	from	to
<u>Top Soil</u>	<u>0</u>	<u>1</u>
<u>Clay</u>	<u>1</u>	<u>22</u>
<u>Coarse Gravel</u>	<u>24</u>	<u>93</u>
<u>Sand &amp; Gravel</u>	<u>93</u>	<u>123</u>

WELL LOCATION:  
sec. 7 T. 3 N. R. 12 E  
4 miles East of Kokomo  
(distance) (direction) (nearest town)

WELL PURPOSE: Home  
(home, irrigation, municipal, industrial)

WELL COMPLETION DATA:

(1) diameter (inches): 4"

(2) total depth (feet): 123 ft

(3) static water level (feet): 80 below above top of ground.

(4) casing: Plastic, 103'  
(material) (depth)  
4"  
(size) If telescope see back.

(5) screen: 20 ft, 103 ft  
(length) (depth to top)  
4" plastic  
(size) (material)

(6) pump: 1/2 10  
(HP) (yield gpm)  
Elec  
(type power)

(7) electric log No  
(yes or no)

(organization running log)

**CODED**


(8) how well bottom plugged  
B.W. Valve

DRILLERS REMARKS:

NOV 9 1973

If well telescopes please sketch and show depths.

GROUND LEVEL

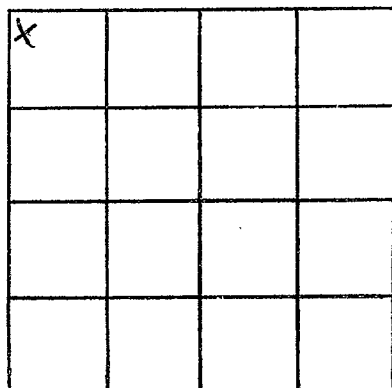

SECTION 25

Please indicate well location X.

ADDITIONAL INFORMATION

If more than one screen,  
show locations of each on sketch.