

MARION  
J62  
11-19-73

MISSISSIPPI  
BOARD OF WATER COMMISSIONERS  
416 North State Street  
Jackson, Mississippi 39201

**CODED**

WATER WELL DRILLERS LOG

11/19 19 93 Yanner - Ginn Marion  
date well completed firm name county well located

LANDOWNER:

Quinn Honeycut  
Rt 2, Tylertown, Miss  
(mailing address)

description of formations encountered

description of formations encountered	from	to
<u>Top Soil</u>	<u>0</u>	<u>1</u>
<u>Clay &amp; gravel</u>	<u>1</u>	<u>23</u>
<u>Sand &amp; Gravel</u>	<u>23</u>	<u>72</u>
<u>Sand</u>	<u>72</u>	<u>103</u>

WELL LOCATION:

sec 35 T 3 N R 12 E  
6 miles S of Kokomo  
(distance) (direction) (nearest town)

WELL PURPOSE:

Home  
(home, irrigation, municipal, industrial)

WELL COMPLETION DATA:

- diameter (inches) 2"
- total depth (feet) 103 ft.
- static water level (feet) 35 below top of ground
- casing: Plastic, 93  
(material) (depth)  
If telescope see back.  
(size)
- screen 10 ft., 93  
(length) (depth to top)  
2", Plastic  
(size) (material)
- pump 1 HP, 6  
(HP) (yield gpm)  
Elec  
(type power)
- electric log \_\_\_\_\_  
(yes or no)  
(organization running log)

**CODED**

(8) how well bottom plugged B.W. Valve


DRILLERS REMARKS:

MAY 26 1973

MISS. BU  
WATER

If well telescopes please sketch and show depths.

GROUND LEVEL

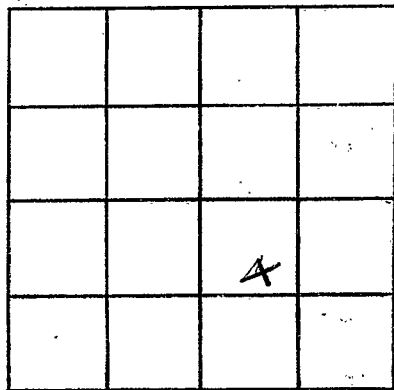

SECTION 35

Please indicate well location X.

ADDITIONAL INFORMATION

If more than one screen,  
show locations of each on sketch.