

MARION
J63
3-18-74

MISSISSIPPI
BOARD OF WATER COMMISSIONERS
416 North State Street
Jackson, Mississippi 39201.

WATER WELL DRILLERS LOG

CODED

3-18 1974 Griser-Corn Marion
date well completed firm name county well located

LANDOWNER:	description of formations encountered	from	to
Edwin Tipit	Top Soil	0	2
Rt. 1 Foxworth (mailing address) Miss	Clay Sand & Gravel Chalk Sand	2 76 74 86 86	26 74 86 100
WELL LOCATION: sec 36 T 3 N R 12 E S W 6 1/2 miles W of Foxworth (distance) (direction) (nearest town)			
WELL PURPOSE: Bone (home, irrigation, municipal, industrial)			
WELL COMPLETION DATA:			
(1) diameter (inches) 4"			
(2) total depth (feet) 100			
(3) static water level (feet) 75 below above top of ground.			
(4) casing plastic, 90 (material) (depth) 4" (size) if telescope see back.			
(5) screen 10' 90 (length) (depth to top) 4" (size) plastic (material)			
(6) pump 1/2 8 (HP) (yield gpm) elec (type power)			
(7) electric log No (yes or no)			
No (organization running log)			
(8) how well bottom plugged B.W. Valve			
DRILLERS REMARKS:			


CODED

MAY 23 1974

MISSISSIPPI BOARD OF WATER COMMISSIONERS

If well telescopes please sketch and show depths.

GROUND LEVEL

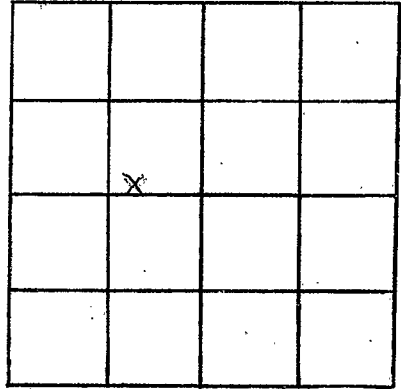

SECTION 36

Please indicate well location X.

ADDITIONAL INFORMATION

If more than one screen, show locations of each on sketch.