

MARION
J65
2-9-74

MISSISSIPPI
BOARD OF WATER COMMISSIONERS
416 North State Street
Jackson, Mississippi 39201

WATER WELL DRILLERS LOG

2-9 1974

GRINER - GINN

Marion

date well completed

firm name

county well located


LANDOWNER:	description of formations encountered	from	to
Mr. Clifton Holmes Rt. 2, Jocassee, Miss. (mailing address)			
WELL LOCATION:			
sec. 19 T. 3 N. R. 12 E. S W			
4 miles W of Jocassee (distance) (direction) (nearest town)			
WELL PURPOSE: Home (home, irrigation, municipal, industrial)			
WELL COMPLETION DATA:			
(1) diameter (inches) 4"			
(2) total depth (feet) 230			
(3) static water level (feet) 140 below top of ground.			
(4) casing plastic, 220 (material) (depth) 4" if telescope see back. (size)			
(5) screen 10', 220 (length) (depth to top) 4" plastic (size) (material)			
(6) pump 1 (HP) 6 (yield gpm) elec (type power)			
(7) electric log No (yes or no) No (organization running log)			
(8) how well bottom plugged BWS Valve			
DRILLERS REMARKS:			

RECORDED
INDEXED
NOV 23 1974

MISS. Bd. of Water Comm.

If well telescopes please sketch and show depths.

GROUND LEVEL

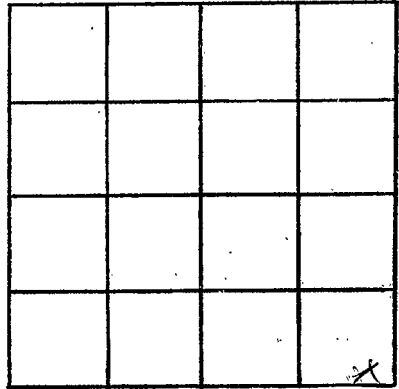

SECTION 19

Please indicate well location X.

ADDITIONAL INFORMATION

If more than one screen, show locations of each on sketch.