

MARION  
 567  
 3-18-74

MISSISSIPPI  
 BOARD OF WATER COMMISSIONERS  
 416 North State Street  
 Jackson, Mississippi 39201

CODED

WATER WELL DRILLERS LOG

GRINER - GINN

Marion

3-18-74  
 date well completed

firm name

county well located

LANDOWNER:	description of formations encountered	from	to
David Seago	Top Soil	0	1
Pl. 2	Clay	1	38
Folworth (mailing address) Miss	Hard & Road	38	104
	Chalk	104	200
	Sand	200	240
<p>WELL LOCATION:</p> <p>sec. 31 T. 3 S. R. 2 E.</p> <p>12 miles S-W of Folworth (distance) (direction) (nearest town)</p>			
<p>WELL PURPOSE: Home (home, irrigation, municipal, industrial)</p>			
<p>WELL COMPLETION DATA:</p> <p>(1) diameter (inches) 4"</p> <p>(2) total depth (feet) 240</p> <p>(3) static water level (feet) 130 below top of ground.</p> <p>(4) casing plastic, 230 (material) (depth) 4" (size) if telescope see back.</p> <p>(5) screen 10' , 230 (length) (depth to top) 4" , plastic (size) (material)</p> <p>(6) pump 1 (HP) 6 (yield gpm) elec. (type power)</p> <p>(7) electric log NO (yes or no) NO (organization running log)</p> <p>(8) how well bottom plugged B.W. Valve</p>			
<p>DRILLERS REMARKS:</p>			


CODED

REGISTERED  
 MAY 23 1974

MISS. BD. OF WATER COMMISSIONERS

If well telescopes please  
sketch and show depths.

GROUND LEVEL

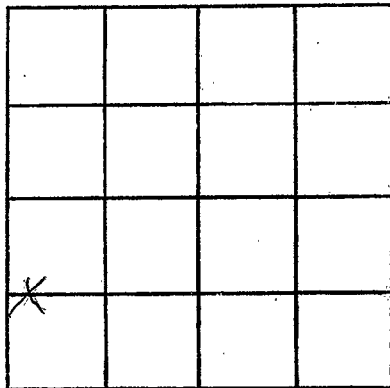

SECTION 31

Please indicate well location X.

ADDITIONAL INFORMATION

If more than one screen,  
show locations of each on sketch.