

MARION
J 68
5/74

MISSISSIPPI
BOARD OF WATER COMMISSIONERS
416 North State Street
Jackson, Mississippi 39201

CODED

WATER WELL DRILLERS LOG

May 74 E.B. Sherrard Marion
date well completed firm name county well located

LANDOWNER:

J.W. Johnson
Kokomo, Ms.
(mailing address)

description of formations encountered

from to

SANDY RED CLAY	0	70
DARK SANDY GR.	70	85
SANDY GRAVELLY	85	150
FINE SAND WITH		
STAY CLAY	150	170
GRAVEL & SAND	170	177

WELL LOCATION:

sec 28 T 30 N R 12 E
1/2 miles E Kokomo
(distance) (direction) (nearest town)

CODED

WELL PURPOSE:


(home) Irrigation, municipal, industrial

WELL COMPLETION DATA:

- (1) diameter (inches) 4"
- (2) total depth (feet) 242'
- (3) static water level (feet) 110' ^{below} above top of ground.
- (4) casing pl. 232' (material) (depth)
4" (size) if telescope see back.
- (5) screen 10' (length) (depth to top)
4 (size) pl. (material)
- (6) pump 1 (HP) 20 (yield gpm)
E (type power)
- (7) electric log (yes or no)

(organization running log)

(8) how well bottom plugged BWV

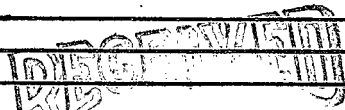


JUL - 1 1974

DRILLERS REMARKS:

MISS. BD. OF WATER COMMISSIONERS

If well telescopes please sketch and show depths.

GROUND LEVEL

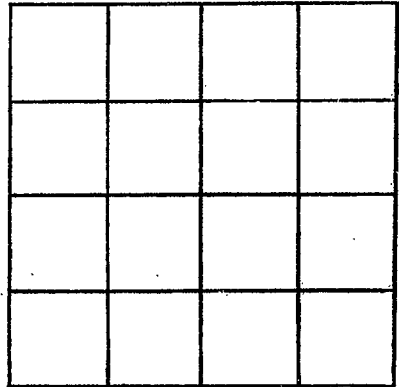

SECTION _____

Please indicate well location X.

ADDITIONAL INFORMATION

If more than one screen, show locations of each on sketch.