

MARION
J69
5/74

MISSISSIPPI
BOARD OF WATER COMMISSIONERS CODED
416 North State Street
Jackson, Mississippi 39201

WATER WELL DRILLERS LOG

May 1974 E. B. Sheppard Marion
date well completed firm name county well located

LANDOWNER:	description of formations encountered	from	to
R. B. Brunfield	LOOSE RED SANDY		
Rt. 1 - Foxworth, Ms. (mailing address)	CLAY SAND & GRAVEL	0	40' 88'

WELL LOCATION:
sec. 11 T. 3 N R. 12 E
S W
4 miles W of Foxworth
(distance) (direction) (nearest town)

WELL PURPOSE:
(home irrigation, municipal, industrial)


- WELL COMPLETION DATA:
- (1) diameter (inches) 2"
 - (2) total depth (feet) 88'
 - (3) static water level (feet) 55' ^{below} above top of ground.
 - (4) casing pl. 83' (material) (depth)
2" if telescope see back. (size)
 - (5) screen 5' (length) (depth to top)
 - (6) pump 1 (HP) 7 (yield gpm)
E (type power)
 - (7) electric log (yes or no) no
(organization running log)
 - (8) how well bottom plugged BWV

DRILLERS REMARKS:

RECEIVED
MAY 1 1974
MISS. Bd. OF WA.

If well telescopes please sketch and show depths.

GROUND LEVEL

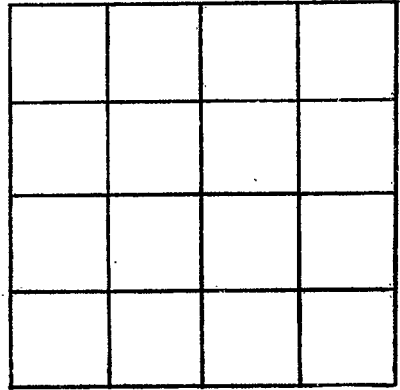

SECTION _____

Please indicate well location X.

ADDITIONAL INFORMATION

If more than one screen, show locations of each on sketch.