

MARION
J 70
4/74

MISSISSIPPI
BOARD OF WATER COMMISSIONERS
416 North State Street
Jackson, Mississippi 39201

CODED

WATER WELL DRILLERS LOG

April 1974 E.B. Sheppard Marion
date well completed firm name county well located

LANDOWNER:
Edwina Ruach
Kokomo, Miss.
(mailing address)

description of formations encountered	from	to
B.F.D SANDY	0	60'
SAND & GR.	60	105'

WELL LOCATION:
sec. 30 T. 3 N. R. 12 E
2 miles W of Kokomo
(distance) (direction) (nearest town)

WELL PURPOSE:
(home, irrigation, municipal, industrial)

WELL COMPLETION DATA:

(1) diameter (inches) 2"

(2) total depth (feet) 105'

(3) static water level (feet) 40' below top of ground.

(4) casing (material) pl (depth) 100'

2" (size) if telescope see back.

(5) screen 5' (length) (depth to top)

2" (size) pl (material)

(6) pump 1 (HP) 7 (yield gpm)


E (type power)

(7) electric log (yes or no)

(organization running log)

(8) how well bottom plugged B.W.V.

CODED

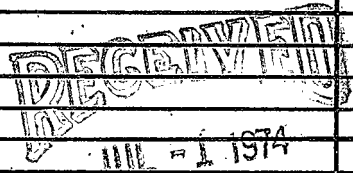


DRILLERS REMARKS:

MISS. BD. OF WATER COMMISSIONERS

If well telescopes please sketch and show depths.

GROUND LEVEL

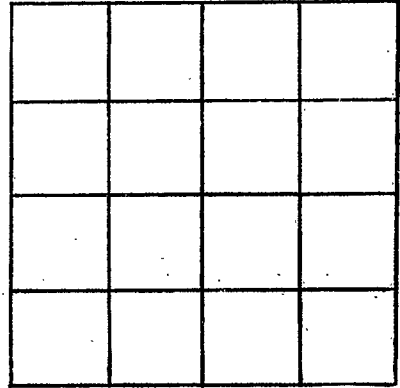

SECTION _____

Please indicate well location X.

ADDITIONAL INFORMATION

If more than one screen, show locations of each on sketch.