

MARION  
J 71  
2174

MISSISSIPPI  
BOARD OF WATER COMMISSIONERS  
416 North State Street  
Jackson, Mississippi 39201

CODED

WATER WELL DRILLERS LOG

Feb. 1974 E. B. Sheppard Marion  
date well completed firm name county/well located

LANDOWNER:  
Clayton J. Lawson  
Forworth, Miss.  
(mailing address)

| description of formations encountered | from | to   |
|---------------------------------------|------|------|
| RED SANDY CLAY                        | 0    | 60'  |
| BLUE CLAY                             | 60   | 150  |
| SAND + PEA CK.                        | 150  | 178' |

WELL LOCATION:  
sec. 15 T. 3 N. R. 12 W.  
6 miles W Forworth  
(distance) (direction) (nearest town)

CODED

WELL PURPOSE:  
 home,  irrigation,  municipal,  industrial

- WELL COMPLETION DATA:
- (1) diameter (inches) 2"
  - (2) total depth (feet) 178'
  - (3) static water level (feet) 110' <sup>below</sup> above top of ground.
  - (4) casing pl. (material) 173' (depth)  
2" (size) if telescope see back.
  - (5) screen 5' (length) (depth to top)  
2" (size) pl. (material)
  - (6) pump 1 1/2 (HP) 7 (yield gpm)  
E (type power)
  - (7) electric log  (yes or no)
  - (8) how well bottom plugged BWV


DRILLERS REMARKS:

DRILLER'S SIGNATURE  
JAN 22 1974

MISS. BD OF WATER COMM.

If well telescopes please sketch and show depths.

GROUND LEVEL

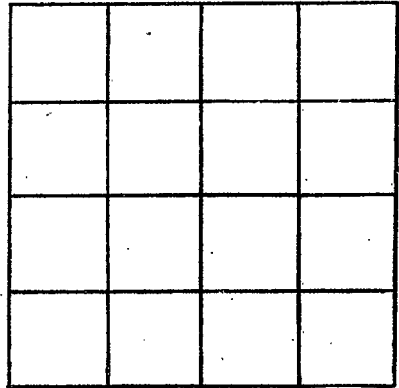

SECTION \_\_\_\_\_

Please indicate well location X.

ADDITIONAL INFORMATION

If more than one screen, show locations of each on sketch.