

MARION
 J 72
 2179

MISSISSIPPI
 BOARD OF WATER COMMISSIONERS
 416 North State Street
 Jackson, Mississippi 39201

CODED

WATER WELL DRILLERS LOG

Feb. 19 74 E. B. Sheppard Marion
 date well completed firm name county well located

LANDOWNER:
 Egon Thompson
 Rt. 1 - Forsyth, Miss.
 (mailing address)

description of formations encountered	from	to
RED SANDY CLAY	0	30'
SAND	30	40'
BLUE CLAY	110	140'
SAND & GR.	140	180'

WELL LOCATION:
 sec. 15 T 3 N R 12 E
 S W
 6 miles W Forsyth
 (distance) (direction) (nearest town)

CODED

WELL PURPOSE:
 (home) irrigation, municipal, industrial

WELL COMPLETION DATA:

(1) diameter (inches) 2"

(2) total depth (feet) 180

(3) static water level (feet) 70' below top of ground.

(4) casing pl. 175' (material) (depth)
 2" (size) if telescope see back.

(5) screen 5' (length) (depth to top)
 2" (size) pl. (material)

(6) pump 1 (HP) 7 (yield gpm)
 E (type power)

(7) electric log (yes or no)

(organization running log)

(8) how well bottom plugged BWV


RECEIVED
 JUL - 1 1974

MISS. BD. OF WATER COMMISSIONERS

DRILLERS REMARKS:

If well telescopes please sketch and show depths.

GROUND LEVEL

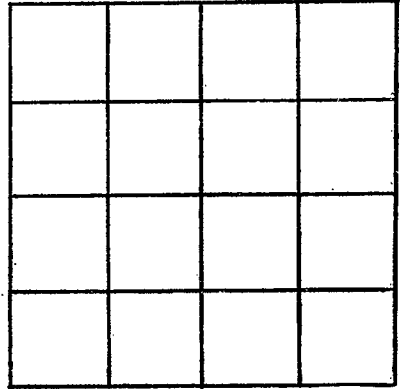

SECTION _____

Please indicate well location X.

ADDITIONAL INFORMATION

If more than one screen,
show locations of each on sketch.