

MARION
J73
10-1-74

MISSISSIPPI
BOARD OF WATER COMMISSIONERS
416 North State Street
Jackson, Mississippi 39201

CODED

WATER WELL DRILLERS LOG

10-1 1974
date well completed

CRIVER-CIVIL
firm name

MARION
county well located

LANDOWNER:
Jessie Lee Johnson
Rt. 2 Foxworth
(mailing address)

description of formations encountered	from	to
TOP Soil	0	1
Clay	1	28
Clay + gravel.	28	104
Chalk & gravel.	104	160
Shells	160	170
Sand	170	700

WELL LOCATION:
sec. 3 T 3 N R 12 E
13 miles W of Foxworth
(distance) (direction) (nearest town)

CODED

WELL PURPOSE: Home
(home, irrigation, municipal, industrial)

WELL COMPLETION DATA:

(1) diameter (inches) 2"

(2) total depth (feet) 200

(3) static water level (feet) 140 below above top of ground.

(4) casing plastic, 190'
(material) (depth)
2" If telescope see back.
(size)

(5) screen 10' 190'
(length) (depth to top)
2" plastic
(size) (material)

(6) pump 2 (HP) (yield gpm)
elec.
(type power)

(7) electric log No
(yes or no)
NO
(organization running log)

(8) how well bottom plugged
B.W. Valve


RECEIVED
DECEMBER 26 1974

DRILLERS REMARKS:

MISS. RD. OF WATER COMM.

If well telescopes please sketch and show depths.

GROUND LEVEL

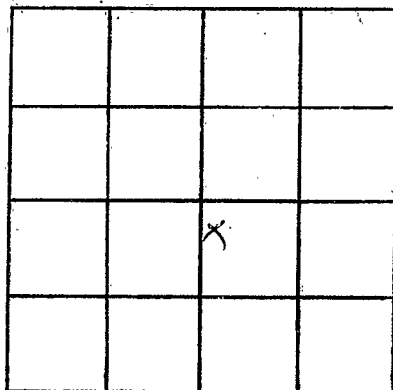

SECTION 3

Please indicate well location X.

ADDITIONAL INFORMATION

If more than one screen,
show locations of each on sketch.