

MARION
 374
 7-11-74

MISSISSIPPI
 BOARD OF WATER COMMISSIONERS
 416 North State Street
 Jackson, Mississippi 39201

WATER WELL DRILLERS LOG

CODED

7-11 1974 Oriner - Orion Marion
 date well completed firm name county well located

LANDOWNER:
Glasgow Hatcher
Rt. 2 Foxworth, Miss.
 (mailing address)

description of formations encountered	from	to
TOP Soil	0	1
Clay	1	30
Clay, Chalk + gravel	30	105
Chalk + gravel	105	130
Chalk	130	165
Sand	165	190

WELL LOCATION:
 sec. 27 T 3 N R 7 E
9 miles SW of Bozomann
 (distance) (direction) (nearest town)

WELL PURPOSE: Home
 (home, irrigation, municipal, industrial)

- WELL COMPLETION DATA:
- (1) diameter (inches) 4"
 - (2) total depth (feet) 190
 - (3) static water-level (feet) 98 below top of ground.
 - (4) casing plastic, 180,
 (material) (depth)
4" If telescope see back.
 (size)
 - (5) screen 10', 180
 (length) (depth to top)
4", plastic
 (size) (material)
 - (6) pump 3/4 (HP) (yield gpm).
elec
 (type power)
 - (7) electric log NO (yes or no)
NO
 (organization running log)
 - (8) how well bottom plugged BWI Valve

CODED


NOV 11 1974
 MISS. BD. OF WATER COMM.
 DEC 26 1974

DRILLERS REMARKS:

MISS. BD. OF WATER COMM.

If well telescopes please sketch and show depths.

GROUND LEVEL

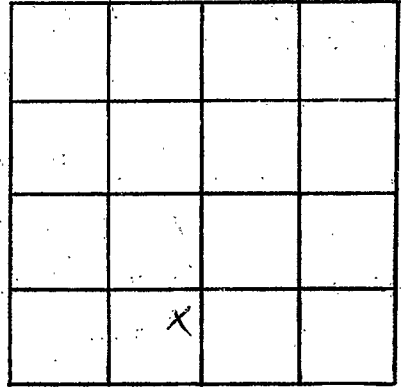

SECTION 27

Please indicate well location X.

ADDITIONAL INFORMATION

If more than one screen, show locations of each on sketch.