

**MISSISSIPPI  
BOARD OF WATER COMMISSIONERS**  
416 North State Street  
Jackson, Mississippi 39201

**CODED**

**WATER WELL DRILLERS LOG**

**MARION**  
**J 75**  
**8-15-74**


8-15 1974 Briner - CIVIL Marion  
date well completed firm name county well located

LANDOWNER:	description of formations encountered	from	to
James Mc Gowan Rt. 1 Foxworth, Miss. (mailing address)			
<b>WELL LOCATION:</b> sec. <u>3</u> T. <u>3</u> N. R. <u>12</u> E. <u>1.3</u> miles <u>W</u> of <u>Foxworth</u> (distance) (direction) (nearest town)	<b>CODED</b>		
<b>WELL PURPOSE:</b> (home, irrigation, municipal, industrial)			
<b>WELL COMPLETION DATA:</b>			
(1) diameter (inches) <u>2"</u>			
(2) total depth (feet) <u>203</u>			
(3) static water level (feet) <u>150</u> below top of ground.			
(4) casing <u>plastic</u> , <u>193</u> , (material) (depth)			
<u>2"</u> (size) if telescope see back.			
(5) screen <u>10'</u> , <u>193</u> , (length) (depth to top)			
<u>2"</u> , <u>plastic</u> (size) (material)			
(6) pump <u>2</u> (HP) (yield gpm) <u>elec.</u> (type power)			
(7) electric log <u>NO</u> (yes or no) <u>NO</u> (organization running log)			
(8) how well bottom plugged, <u>B.W. Valve</u>			
<b>DRILLERS REMARKS:</b>			

**RECEIVED  
DECEMBER 26 1974**

If well telescopes please sketch and show depths.

GROUND LEVEL

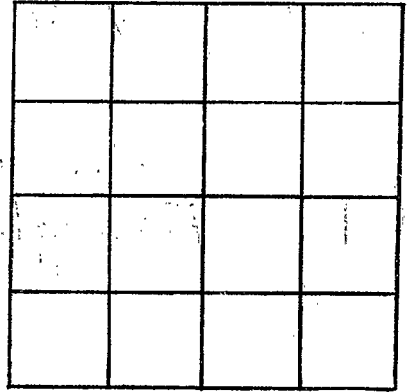

SECTION \_\_\_\_\_

Please indicate well location X.

ADDITIONAL INFORMATION

If more than one screen, show locations of each on sketch.