

MARION  
 576  
 8-1-74

MISSISSIPPI  
 BOARD OF WATER COMMISSIONERS  
 416 North State Street  
 Jackson, Mississippi 39201

CODED

WATER WELL DRILLERS LOG

8-1 date well completed      1974 Brewer - BIRD firm name      Marion county well located

LANDOWNER:  
 Roger Mulford  
 Rt. 1, Foxworth  
 (mailing address)

description of formations encountered	from	to
Top Soil	0	1
Clay	1	75
Clay + gravel	75	110
Chalk & gravel	110	145
Chalk	145	180
Sand	180	200

WELL LOCATION:  
 sec. 12 T 3 N R 12 E  
 9 miles W of Foxworth  
 (distance) (direction) (nearest town)

WELL PURPOSE: Home  
 (home, irrigation, municipal, industrial)

CODED

- WELL COMPLETION DATA:
- (1) diameter (inches) 2"
  - (2) total depth (feet) 200
  - (3) static water level (feet) 120' below top of ground.
  - (4) casing plastic, 190' (material) (depth)  
 2" if telescope see back. (size)
  - (5) screen 10' 190' (length) (depth to top)  
 2" plastic (size) (material)
  - (6) pump 2 (HP) (yield gpm)  
 elec. (type power)
  - (7) electric log 190 (yes or no)  
 NO (organization running log)
  - (8) how well bottom plugged  
 B.W. Valve


RECEIVED  
 DEC 20 1974

DRILLERS REMARKS:

MISS. RD. OF WATER COMM

If well telescopes please sketch and show depths.

GROUND LEVEL

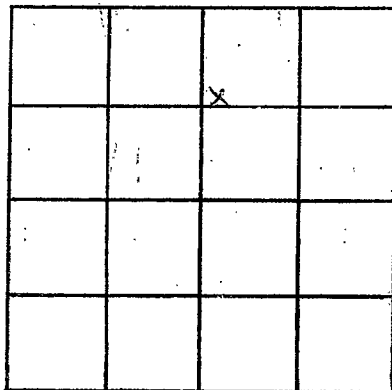

SECTION 12

Please indicate well location X.

ADDITIONAL INFORMATION

If more than one screen,  
show locations of each on sketch.