

MARION
 J 77
 5-9-74

MISSISSIPPI
 BOARD OF WATER COMMISSIONERS
 416 North State Street
 Jackson, Mississippi 39201

WATER WELL DRILLERS LOG

5-9 1974 Griner - Linn Marion
 date well completed firm name county well located

LANDOWNER:
Ray Regan
Rt. 1 Columbia
 (mailing address) Miss

description of formations encountered	from	to
	<u>Top Soil</u>	<u>0</u>
<u>Clay</u>	<u>1</u>	<u>29</u>
<u>Chalk</u>	<u>29</u>	<u>56</u>
<u>Sand</u>	<u>56</u>	<u>73</u>

WELL LOCATION:
 sec. 2 T. 3 N. R. 12 E.
10 miles NW of Forest
 (distance) (direction) (nearest town)

WELL PURPOSE: Home
 (home, irrigation, municipal, industrial)

WELL COMPLETION DATA:

(1) diameter (inches) 2"

(2) total depth (feet) 73

(3) static water level (feet) 40 below above top of ground.

(4) casing plastic, 63,
 (material) (depth)
2" If telescope see back.
 (size)

(5) screen 10', 63
 (length) (depth to top)
2", plastic
 (size) (material)

(6) pump 1/2 elec
 (HP) (yield gpm)
 (type power)

(7) electric log NO
 (yes or no)
NO
 (organization running log)

(8) how well bottom plugged B.W. Valve

CODED


RECEIVED
 DEC 20 1974

DRILLERS REMARKS:

MISS. Bd. OF WATER COMM.

If well telescopes please sketch and show depths.

GROUND LEVEL

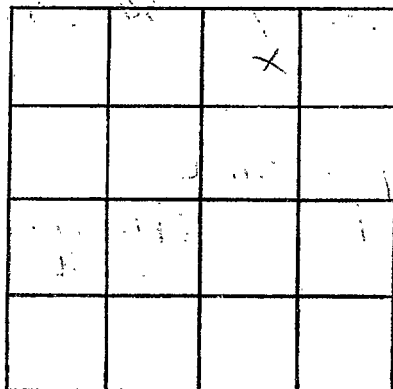

SECTION 2

Please indicate well location X.

ADDITIONAL INFORMATION

If more than one screen, show locations of each on sketch.