

Marion
J 78
10/74

MISSISSIPPI
BOARD OF WATER COMMISSIONERS
416 North State Street
Jackson, Mississippi 39201 **CODED**

WATER WELL DRILLERS LOG

Oct. 19 74 E. B. Sherrard Marion
date well completed firm name county well located

LANDOWNER:
Wendell Sullivan
Rt. 1 - Kokomo, Ms.
(mailing address)

description of formations encountered	from	to
RED SANDY CLAY	0	90
LOOSE LARGE GR.	90	120
DEA GR. + SAND	120	170

WELL LOCATION:
sec 24 T 3 N R 12 E
4 1/2 miles W of Forrest
(distance) (direction) (nearest town)

WELL PURPOSE:
Home irrigation, municipal, industrial


- WELL COMPLETION DATA:
- (1) diameter (inches) 2"
 - (2) total depth (feet) 170'
 - (3) static water level (feet) 126' below top of ground.
 - (4) casing pl. 165'
(material) (depth)
2" if telescope see back.
(size)
 - (5) screen 5' pl.
(length) (depth to top)
2" pl.
(size) (material)
 - (6) pump 1 1/2 6
(HP) (yield gpm)
E
(type power)
 - (7) electric log (yes or no)
 - (organization running log)
 - (8) how well bottom plugged BWV

REGISTERED
MAY 8 1975

DRILLERS REMARKS:

If well telescopes please sketch and show depths.

GROUND LEVEL

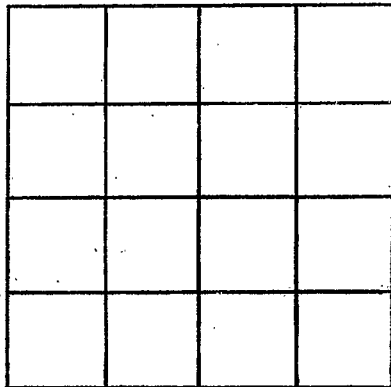

SECTION _____

Please indicate well location X.

ADDITIONAL INFORMATION

If more than one screen, show locations of each on sketch.